GENERAL NOTES:

- 1. ALL ELEVATIONS ARE REFERENCED TO THE NORTH AMERICAN VERTICAL DATUM OF 1988 (NAVD88) WHICH IS
- 2. THE BOROUGH OF MANHATTAN VERTICAL DATUM IS 2.752 FEET ABOVE U.S.C. AND THE NATIONAL GEODETIC
- SURVEY VERTICAL DATUM OF 1929 (NGVD29), MEAN SEA LEVEL, SANDY HOOK, NEW JERSEY. 3. THE NYCTA ELEVATION IS 1.553 FEET ABOVE THE NAVD88 + 100.0' FOR NEW YORK CITY TRANSIT AUTHORITY
- COORDINATION (EXAMPLE, NAVD88 EL. 65.0' = NYCTA 163.447') 4. PROPOSED FINISHED FIRST FLOOR ELEVATION IS NAVD88 EL 39.85'.
- 5. BASE PLANS AND SECTIONS ARE DEVELOPED FROM:
- 5.1. STRUCTURAL AND FOUNDATION DRAWINGS BY WSP GROUP OF NEW YORK, NY, DATED 04.29.2016. 5.2. SURVEY DRAWING BY LANGAN OF NEW YORK, NY, DATED 03.03.2015.
- 5.3. BORING LOCATION PLAN BY LANGAN OF NEW YORK, NY DATED 05.18.2015.

1.652 FEET BELOW THE BOROUGH OF MANHATTAN VERTICAL DATUM, SEE NOTE 2.

- 6. SOIL DATA OBTAINED FROM: GEOTECHNICAL REPORT BY LANGAN OF NEW YORK, NY DATED 05.18.2015
- 7. LOCATION OF EXISTING AND PROPOSED CONDITIONS INCLUDING BUT NOT LIMITED TO FOUNDATION WALL FOOTINGS AND SLAB LOCATIONS AND ELEVATIONS WERE TAKEN FROM DRAWINGS AND INFORMATION REFERENCE
- 8. LOCATIONS AND ELEVATIONS OF ALL STRUCTURAL BUILDING ELEMENTS SHOWN ON THIS DRAWING MAY BE
- APPROXIMATE AND SHALL BE SUPERSEDED BY FINAL STRUCTURAL AND ARCHITECTURAL DRAWINGS. 9. IT IS THE CONTRACTOR'S RESPONSIBILITY TO LOCATE UTILITIES AND BELOW GROUND STRUCTURES IN THE AREA
- 10. IT IS THE CONTRACTOR'S RESPONSIBILITY TO VERIFY ALL DIMENSIONS IN THE FIELD. IF CONDITIONS OBSERVED
- IN THE FIELD DIFFER FROM THESE DRAWINGS, THE CONTRACTOR SHALL NOTIFY THE ENGINEER TO EVALUATE THE CONDITION. MODIFICATIONS TO THESE DRAWINGS MAY BE NECESSARY. 11. THESE DRAWINGS DO NOT ADDRESS SAFETY ISSUES RELATED TO THE EXCAVATION AND SHORING WORK.
- OTHERS SHALL BE RESPONSIBLE FOR SITE SAFETY AND PROVIDE A SAFETY PLAN CONFORMING TO OSHA AND ALL APPLICABLE LAWS
- 12. BARRIERS AND FENCING AROUND SITE MUST BE PROVIDED BY CONTRACTOR IN ACCORDANCE WITH NEW YORK CITY DEPARTMENT OF BUILDINGS AND ALL APPLICABLE LAWS.
- 13. IF THE CONDITIONS OBSERVED AS THE EXCAVATION ADVANCES ARE DIFFERENT THAN THE CONDITIONS SHOWN ON THE DESIGN DRAWINGS, THE CONTRACTOR SHALL STOP WORK AND NOTIFY THE CONSTRUCTION MANAGER AND ENGINEER TO ADDRESS FIELD CONDITIONS.
- 14. OBSERVED MOVEMENTS OF THE SUPPORT OF EXCAVATION OR OTHER STRUCTURES SHALL BE BROUGHT TO THE ATTENTION OF THE CONSTRUCTION MANAGER AND ENGINEER
- 15. LOOSE AREAS OF FOUNDATION WALL OR FOOTINGS THAT ARE DAMAGED OR LOOSE SHOULD BE BROUGHT TO THE ATTENTION OF THE ENGINEER FOR EVALUATION AND REMEDIAL MEASURES BY THIS OFFICE OR AT DIRECTION
- 16. PINS, WIRE MESH, AND PARGING MAY BE REQUIRED TO STABILIZE THE FOUNDATION WALL OR FOOTINGS NOT
- 17. ALL EXPOSED ADJACENT FOUNDATION WALLS OF BRICK, MASONRY, RUBBLE, OR THE LIKE SHALL BE CEMENT PARGED TO SEAL AND WEATHERPROOF. CEMENT PARGE MAY BE INSTALLED BY TROWEL, SHOTCRETE, OR OTHER SUITABLE METHOD BY CONTRACTOR.
- 18. ALL WELDING SHALL BE PERFORMED IN ACCORDANCE WITH AWS D1.1 USING E-70 ELECTRODES.
- 19. ALL STRUCTURAL STEEL SHALL BE GRADE 50, ASTM A-572.
- 20. ALL PLATES OR MISCELLANEOUS STEEL SHALL BE GRADE 36, ASTM A36.
- 21. 1-BAG MIX SHALL CONSIST OF 1-94 LB. BAG OF CEMENT TO 1 CY OF SAND. QUANTITY OF WATER SHALL BE ADEQUATE TO ALLOW THE MIX TO FLOW. 22. THE DESIGNS ON THESE DRAWINGS ARE INTENDED FOR TEMPORARY SUPPORT OF EXCAVATION ONLY.
- 23. NOTIFY DOB 24 TO 48 HOURS PRIOR TO EXCAVATION (RULE 52).

TIE BACKS AND STRESSED ANCHORAGES:

- 1. CONTRACTOR IS FULLY RESPONSIBLE FOR THE VERIFICATION OF EXISTING UTILITIES AND OTHER EXISTING CONDITIONS PRIOR TO COMMENCEMENT OF DRILLING OPERATIONS.
- 2. STRESSED/LOADED TIE BACK ANCHORAGES SHALL BE GRADE 150KSI, ASTM A722 THREADED BARS SUPPLIED BY STRESSBAR SYSTEMS INTERNATIONAL (SSI), OR APPROVED EQUIVALENT. ALTERNATE HOLLOW CORE, SELF
- DRILLING ANCHORS ARE ALSO INDICATED IN THESE DRAWINGS, AS SUPPLIED BY SSI, OR APPROVED EQUIVALENT. 3. BAR DIAMETERS INDICATED IN THESE DRAWINGS SHALL BE THE MINIMUM SIZE USED. LARGER DIAMETERS MAY
- BE SUBSTITUTED WITHOUT PRIOR APPROVAL OF ENGINEER. DRILL HOLES INDICATED IN THESE DRAWINGS SHALL BE THE MINIMUM PROVIDED. A CHANGE IN DRILL HOLE
- DIAMETER WILL EFFECT THE REQUIRED BOND LENGTHS INDICATED.
- 5. BOND LENGTHS INDICATED IN THESE DRAWINGS SHALL BE MINIMUM, AND MAY BE SUBJECT TO CHANGE AND/OR VERIFICATION AT DIRECTION OF FIELD PROFESSIONAL ENGINEER.
- 6. THE FIRST TIE-BACK INSTALLED, AND 1% REMAINING ANCHORS SHALL BE SUBJECT TO PERFORMANCE TESTING, UNDER LATEST POST TENSIONING INSTITUTE (PTI) RECOMMENDATIONS FOR SOIL AND ROCK ANCHORS. 7. THE BALANCE OF INSTALLED TIE-BACKS SHALL BE PROOF-TESTED TO LOAD VALUES INDICATED ON THESE
- 8. ANCHORAGES SUPPORTING THE EXISTING FOUNDATION WALL MAY BE EXEMPT FROM TESTING TO AVOID UNNECESSARY OVERSTRESSING OF THE EXISTING WALL CONSTRUCTION, AT DIRECTION OF FIELD ENGINEER.
- THESE ANCHORAGES SHALL BE INSTALLED, AND STRESSED TO LOCK-OFF LOADING INDICATED. 9. ALL ANCHORAGE STRESSING SHALL BE CONDUCTED USING A CALIBRATED CENTER HOLE HYDRAULIC JACK
- CAPABLE OF EXCEEDING MAXIMUM TESTING LOADS INDICATED IN THESE DRAWINGS. 10. CONTRACTOR IS RESPONSIBLE FOR ESTABLISHING SAFE ENVIRONMENT DURING TESTING, AND ALSO PROVIDING
- REQUIRED EQUIPMENT (INCLUDING, BUT NOT LIMITED TO, HYDRAULIC JACK, STEEL JACK CHAIRS, DIAL INDICATORS, INDEPENDENT TRI PODS) AS REQUIRED FOR FIELD MEASUREMENTS/VERIFICATION DURING TESTING. 11. IF IN THE EVENT A TIE-BACK ANCHOR DOES NOT PASS TESTING, AT THE OPINION OF THE FIELD ENGINEER,
- DIAMETERS, AND/OR LONGER LENGTHS AS REQUIRED TO PROVIDE ADEQUATE CAPACITY TO COMPENSATE FOR 12. CONTRACTOR SHALL PROVIDE BOND-BREAK MATERIAL ALONG THE "FREE STRESSING LENGTH" AS INDICATED IN

ADDITIONAL ANCHORAGES MAY BE REQUIRED TO BE INSTALLED AT LARGER DIAMETERS, LARGER DRILL

- THESE DRAWINGS, UNLESS OTHERWISE INDICATED FOR A "FULL LENGTH BOND" ANCHOR, WHICH CASE THE THREADED BAR SHALL BE CONTINUOUSLY GROUTED ALONG FULL LENGTH.
- 13. FOR SOLID, GRADE 150KSI THREADED BARS:
- 13.1. INSTALLATION SHALL BE VIA CASE DRILLING TO AVOID ANY LOSS OF SOILS. 13.2. DRILL FULL LENGTH AS INDICATED ON THESE DRAWINGS, MINIMALLY, UNLESS OTHERWISE DIRECTED BY

FINAL LOCK-OFF VALUE IS TO BE AT DIRECTION OF FIELD ENGINEER.

- 13.3. INSERT BAR INTO PRE-DRILLED CASING.
- 13.4. PUMP CASING WITH GROUT. AS OF COMMON DRILLING PRACTICE, CONTINUE TO "PRESSURE GROUT" WHILE EXTRACTING CASING, AND CYCLE CASING REMOVAL IN-AND-OUT TO CREATE "GROUT BULBS", THIS WILL ENSURE BETTER ANCHOR PERFORMANCE (APPLICABLE TO SOIL BONDED ANCHORS, NEGLECT FOR ROCK
- 13.5. ALLOW ADEQUATE GROUT CURE PRIOR TO TESTING. 5,000PSI GROUT MIX (TYPICAL, 28-DAY) FOR ANCHORS SHALL CONSIST OF:
- 13.5.1. 1 BAG CEMENT, TYPE 1, 2, OR 3 5 GALLONS POTABLE WATER 13.5.2. TESTING TYPICALLY CAN OCCUR WITHIN 3 DAYS OF INSTALLATION, OR AT DIRECTION OF FIELD
- 14. UPON TESTING OF ALL REQUIRED ANCHORS, A LIFT-OFF TEST MAY BE PERFORMED AT DIRECTION OF FIELD ENGINEER IN ORDER TO VERIFY PROPER LOAD TRANSFER AND TO COMPENSATE FOR ANY SEATING LOSSES.

SUPPORT OF EXCAVATION NOTES:

- SURCHARGE LOADING AT SIDEWALK GRADE AT A VALUE OF 600 POUNDS PER SQUARE FOOT (PSF). HEAVY EQUIPMENT OR MATERIAL STORAGE ANTICIPATED SHALL BE PLACED WITHIN A DISTANCE TO THE SHEETING WALL EQUAL TO THE EXCAVATION DEPTH, MUST BE EVALUATED BY THIS OFFICE FOR ACCEPTANCE PRIOR TO PLACING 2. STRUCTURAL CONCRETE FOR UNDERPINNING PIERS SHALL HAVE A MINIMUM COMPRESSIVE STRENGTH OF
- 3. CONCRETE PIERS AND DRY PACK SHALL BE ALLOWED TO CURE PRIOR TO EXCAVATING ADJACENT PIT, OR ADVANCING THE EXCAVATION IN FRONT OF THE PIT.
- 4. DRY PACK SHALL CONSIST OF ONE PART CEMENT TO TWO PARTS SAND BY VOLUME. WATER SHALL BE ADDED TO PRODUCE A MIXTURE WHICH HOLDS ITS SHAPE WHEN FORMED INTO A BALL BY HAND.
- 5. GROUTING TO STABILIZE SOIL AT UNDERPINNING PITS SHALL BE PERFORMED USING SODIUM SILICATE OR MICROFINE CEMENT. GROUT MIX DESIGN, EQUIPMENT, DRILLING PROCEDURE, AND SEQUENCE SHALL BE PERFORMED BY THE CONTRACTOR AND SUBMITTED FOR REVIEW.

1. THE TEMPORARY SHEETING WALL (SUPPORT OF EXCAVATION) IS DESIGNED WITH AN ADDED ALLOWABLE

6. TIMBER LAGGING SHALL BE ROUGH CUT, FULL SIZE CONSTRUCTION GRADE, WITH A MINIMUM ALLOWABLE BENDING STRESS OF 1900-PSI FOR 3" & 4", 1950-PSI FOR 5". TIMBER SIZES SHOWN ARE ACTUAL SIZES. 7. DEPTH OF EXCAVATION BELOW FOOTING AND PREVIOUSLY INSTALLED LAGGING BOARDS SHALL NOT EXCEED 36 INCHES, OR AT DIRECTION FIELD PROFESSIONAL ENGINEER. MAINTAIN TIGHT CONTACT BETWEEN SOIL AND

LAGGING BOARDS. IF MATERIAL IS CAVING INTO EXCAVATION, DECREASE THE UNBRACED EXCAVATION DEPTH

- AND/OR GROUT THE MATERIAL TO MINIMIZE LOSS. 8. IF MATERIAL BEHIND LAGGING HAS BEEN LOST OR DISTURBED, LEAVE A 1 TO 1 1/2-INCH SPACE BETWEEN
- 9. EXCAVATION FOR UNDERPINNING PIERS MUST BE PERFORMED IN DRY CONDITIONS. DEWATERING MAY BE NECESSARY PRIOR TO EXCAVATION TO MAINTAIN WATER LEVELS A MINIMUM OF 1 FOOT BELOW THE PROPOSED SUBGRADE LEVEL OF THE PIER. HAY OR FILTER FABRIC SHALL BE USED TO MINIMIZE MIGRATION OF FINES INTO
- 10. UNDERPINNING PIER SUBGRADE BEARING MATERIAL SHALL BE EQUAL OR BETTER CLASS THAN THE ORIGINAL
- BEARING MATERIAL 11. MAXIMUM PIT WIDTH IS 4 FEET UNLESS OTHERWISE NOTED ON THE DRAWINGS.

LAGGING BOARDS TO IMMEDIATELY BACKFILL OR GROUT.

- 12. APPROACH PITS FOR UNDERPINNING PITS SHOULD CAUSE MINIMAL DISTURBANCE TO SOIL SUBGRADE BELOW THE FOOTING. IT IS THE CONTRACTORS RESPONSIBILITY TO DESIGN THE APPROACH PITS AND EXCAVATE PITS
- FOLLOWING OSHA AND LOCAL LAWS. 13. EXCAVATE PITS SUCH THAT A MINIMUM OF 12 FEET OF UNDISTURBED SOIL OR CURED UNDERPINNING PIER IS
- MAINTAINED BETWEEN OPEN PITS UNTIL ALL UNDERPINNING IS COMPLETE. 14. DO NOT LEAVE PITS OPEN OVERNIGHT OR DURING WEEKENDS OR HOLIDAYS.
- 15. DO NOT START UNDERPINNING WITH A CORNER OR END UNDERPINNING PIER.
- 16. TOP OF UNDERPINNING PIER SHALL MATCH EXISTING FOOTING THICKNESS OR 3'-0" MAX., AND BASE OF UNDERPINNING PIER THICKNESS SHALL BE 3'-0" MIN. IF FIELD CONDITIONS DO NOT ALLOW TO MEET THESE DIMENSIONS CONTACT FNA OFFICE.
- 17. UNDERPINNING SHALL BE CONSTRUCTED IN ONE VERTICAL LIFT, NO COLD JOINTS. 18. ROCK BOLTS MAY BE REQUIRED BASED ON ROCK FACE OBSERVATIONS AT DIRECTION OF FIELD PROFESSIONAL
- 19. CONTRACTOR IS RESPONSIBLE FOR COMPLIANCE WITH NEW YORK CITY BUILDINGS BULLETIN #2009-11, AS APPLICABLE, FOR ONE FACE FORMS AND NEW FOUNDATION WALL POURS AGAINST ADJACENT FOUNDATION

DRILLED PIPE SOLDIER PILES & LAGGING:

- 1. SOLDIER PILE CASING SHALL BE INSTALLED USING INTERNAL FLUSH DUPLEX DRILLING METHOD. CONTRACTOR SHALL ADJUST DRILLING PROCEDURE AS REQUIRED TO PREVENT LOSS OF GROUND, SETTLEMENT AND/OR LATERAL MOVEMENT OF BUILDINGS, UTILITIES, AND OTHER STRUCTURES.
- 2. NO LOSS OF MATERIAL FROM THE OUTSIDE OF THE SOLDIER PILE WILL BE PERMITTED. THE CONTRACTOR SHALL ADOPT THE NECESSARY DRILLING PROCEDURES TO PREVENT LOSS OF MATERIAL FROM AROUND THE OUTSIDE OF
- 3. STEEL CASING SHALL HAVE A MINIMUM WALL THICKNESS OF 0.50-INCHES. SPLICES IN THE CASING SHALL BE THREADED AND FULLY WELDED (ADDITIONAL INTERNAL REINFORCEMENT MAY BE REQUIRED IF SEAMS ARE NOT
- 4. THE BOTTOM OF EACH DRILLED SOLDIER PILE SHALL BE PROTECTED BY A HIGH-STRENGTH CUTTING SHOE WITH HARDENED CUTTING EDGE. 5. NO CONCRETE OR GROUT SHALL BE PLACED AT ANY SOLDIER PILE LOCATION UNTIL TIP ELEVATION HAS BEEN
- CONFIRMED, CLEANED OF MUD AND ANY EXTRANEOUS MATERIAL, AND INSPECTED AND APPROVED BY THE FIELD
- 6. CONCRETE OR GROUT SHALL BE PLACED CONTINUOUSLY FOR THE FULL DEPTH OF THE SOLDIER PILE STARTING AT THE BOTTOM. NO COLD JOINT IS ALLOWED. FINAL DETERMINATION OF THE ELEVATION OF THE SOLDIER PILE TIP WILL BE DETERMINED BY THE FIELD
- 8. THE ENGINEER MAY DIRECT AN INCREASE IN SOLDIER PILE DEPTH FROM THAT SPECIFIED HEREIN OR AS SHOWN ON THE DRAWINGS IF INFERIOR SOIL IS ENCOUNTERED ABOVE THE ORIGINAL MINIMUM TIP ELEVATION.
- 9. NO SOLDIER PILE SHALL BE OUT OF PLUMB MORE THAN ONE PERCENT (1%) OF ITS EMBEDDED LENGTH.
- 10. BEFORE BRACING IS INSTALLED, MAXIMUM EXCAVATION BELOW BRACING LEVEL IS 2-FT FOR WALERS AND RAKERS UNLESS NOTED ON DRAWING OR AT DIRECTION OF FIELD ENGINEER.

11. LAGGING SHALL BE INSTALLED AS THE EXCAVATION ADVANCES WITH A MAXIMUM DEPTH OF 2-FT PRIOR TO

LAGGING INSTALLATION. THE MAXIMUM DEPTH EXPOSURE MAY BE ADJUSTED DEPENDENT ON OBSERVED SOIL

- CONDITIONS UNDER THE REVIEW OF THE SPECIAL INSPECTOR. NO PERSON SHALL ENTER ADJACENT TO AN UNSHORED VERTICAL SOIL CUT EXCEEDING 5'-0' 12. IF MATERIAL BEHIND LAGGING HAS BEEN LOST OR DISTURBED, LEAVE A 1- TO 1-1/2 INCH SPACE BETWEEN
- LAGGING BOARDS TO IMMEDIATELY BACKFILL OR GROUT. 13. HAY OR FILTER FABRIC SHALL BE USED TO MINIMIZE MIGRATION OF FINES INTO THE EXCAVATION.

MINIPILE INSTALLATION NOTES:

- 1. ALL PILES SHALL BE INSTALLED AT LOCATIONS AS SHOWN ON CONTRACT DRAWINGS.
- 2. LAYOUT OF PILE LOCATIONS BY G.C. (SURVEYED IN PLACE).
- 3. UTILITY IDENTIFICATION AND EXPLORATION AS NECESSARY BY G.C.
- 4. THE DIAMETER OF THE CUTTING SHOE OF THE CASING SHALL NOT EXCEED THE OUTER DIAMETER OF THE CASING BY 1/4-INCH.
- 5. "GROUT" TO MIXTURE OF SAND AND CEMENT-GROUT TO ATTAIN SPECIFIED STRENGTH.
- 6. A SET OF SIX 2-INCH BY 2-INCH CUBES OF GROUT SHALL BE TAKEN EACH DAY DURING WHICH MINIPILES ARE GROUTED. CUBES SHALL BE THEN TESTED BY AN INDEPENDENT TESTING LABORATORY IN ACCORDANCE WITH THE CONTRACT SPECS.

MINIPILE INSTALLATION PROCEDURE:

MOBILIZATION TO SITE.

LEAST 24 HOURS.

- 2. SET UP RIG ON PROPER LOCATION AND PLUMB MAST.
- 3. DRILL PILES USING DUPLEX DRILLING METHODS. FLUSH WATER ONLY.
- NOTE: WHEN CLEANING THE INSIDE CASING, 2-DIAMETERS OR TWO FOOT SHOULD BE MAINTAINED BEHIND THE TIP OF THE
- 4. CASING IS DRILLED-IN TO THE BOTTOM OF THE GROUT (BOND) ZONE AS INDICATED ON DRAWINGS.
- 6. INTRODUCE REINFORCING THREADED BAR WITH SPACERS, AND PUSH TO THE BOTTOM OF THE PILE.

5. FLUSH HOLE CLEAN OF SPOILS. IF PILE TIP IS BELOW GWT, FLUID LEVEL INSIDE CASING, AND GROUT THE PILE FROM THE

BOTTOM TO DISPLACE THE DRILLING FLUID. CONTINUE GROUTING UNTIL GOOD GROUT FLOWS OUT THE TOP OF THE PILE.

- 7. START PULLING THE CASING IN 5-FOOT INCREMENTS WHILE PUMPING GROUT AND MAINTAINING 75 PSI GROUT PRESSURE BUT NOT EXCEEDING 100 PSI.
- NOTE: GROUTING OF THE BOND ZONE WILL CEASE IF OVER 150% OF ITS THEORETICAL VOLUME IS PUMPED IN. ACTUAL VOLUME TO BE SPECIFIED BY CONTRACTOR. 8. WHEN CASING REACHES THE ELEVATION REQUIRED BY THE INFLUENCE LINE IT SHALL BE PUSHED BACK DOWN 5-FEET.
- 9. CUT THREADED BAR TO PROPER ELEVATION AS SHOWN ON CONTRACT DRAWINGS. 10. THE INSTALLATION OF ADDITIONAL PILES IN THE SAME CAP SHALL NOT BE INSTALLED UNTIL GROUT HAS CURED FOR AT

SURVEY AND MONITORING NOTES:

- 1. A PRE-CONSTRUCTION (PRE-CONDITION) SURVEY OF THE ADJACENT STRUCTURES SHALL BE COMPLETED PRIOR TO CONSTRUCTION COMMENCEMENT. THE CONTRACTOR SHALL REVIEW AND FAMILIARIZE HIMSELF WITH THE RESULTS OF THE SURVEY. THE CONTRACTOR SHALL MAKE A VISUAL INSPECTION OF THE ADJACENT STRUCTURES (INSIDE AND OUT) PRIOR TO STARTING THE WORK.
- 2. MONITOR THE ADJACENT BUILDINGS AT 50-FT INTERVALS FOR VERTICAL AND LATERAL MOVEMENT.
- 3. OBTAIN BASELINE READINGS OF THE MONITORING POINTS PRIOR TO AND DURING EXCAVATION AND NEW CONSTRUCTION. BASELINE SURVEY SHALL INCLUDE ESTABLISHING VERTICAL AND HORIZONTAL BENCHMARKS OF ALL ADJACENT BUILDINGS. IN ADDITION TO BENCHMARKS, "TELL-TALES" SHALL BE INSTALLED ON ANY OBSERVED EXISTING CRACKS AND OTHER CRITICAL/SENSITIVE AREAS.
- 4. FREQUENCY OF MONITORING WILL VARY DURING PROGRESS OF WORK. PERFORM OPTICAL SURVEYS (BY OTHERS) AT LEAST ONCE PER DAY DURING INITIAL/CRITICAL EXCAVATIONS AND UNDERPINNING. DURING GENERAL EXCAVATIONS, FREQUENCY SHALL BE AT LEAST ONCE PER WEEK. IF MOVEMENTS OCCUR, INCREASE THE FREQUENCY OF THE READINGS AS DIRECTED BY THE ENGINEER. ALL SURVEY/MONITORING REPORTS SHALL BE PROVIDED TO THIS OFFICE DAILY OR UPON COMPLETION OF THAT DAY'S READINGS.
- 5. VIBRATION MONITORS (SEISMOGRAPHS-BY OTHERS) SHALL BE PLACED ADJACENT TO AREAS WHERE WORK IS BEING PERFORMED. NOTE THAT SEISMOGRAPH LOCATIONS ARE NOT SHOWN ON THE SUPPORT OF EXCAVATION PLAN FOR CLARITY (NYCTA MONITORING BY OTHERS)
- 6. BUILDING MOVEMENT AND VIBRATION CRITERIA: (NOTE: THE FOLLOWING DOES NOT APPLY TO LANDMARK STRUCTURES, REFER TO OTHER NOTES)
- A. IF THE VERTICAL OR LATERAL BUILDING MOVEMENT REACHES 1/4-INCH IMMEDIATELY NOTIFY THE
- CONSTRUCTION MANAGER AND ENGINEER. B. IF THE BUILDING EXCEEDS 1/4-INCH, IMMEDIATELY INFORM THE CONSTRUCTION MANAGER AND ENGINEER AND STOP WORK. THE WORK SHALL RESUME UPON APPROVAL BY THE CONSTRUCTION MANAGER AND APPROVED
- REMEDIAL MEASURES AND/OR MODIFIED CONSTRUCTION PROCEDURES BY THE ENGINEER. C. IF THE VIBRATIONS REACH 1-INCHES PER SECOND (IPS) THE CONSTRUCTION MANAGER AND ENGINEER SHALL BE NOTIFIED IMMEDIATELY.
- D. IF THE VIBRATIONS EXCEED 2-IPS, IMMEDIATELY INFORM THE CONSTRUCTION MANAGER AND ENGINEER AND STOP WORK. THE WORK SHALL RESUME UPON APPROVAL BY THE CONSTRUCTION MANAGER AND APPROVED REMEDIAL MEASURES AND/OR MODIFIED CONSTRUCTION PROCEDURES BY THE ENGINEER.
- 7. VIBRATION MONITORS SHALL TAKE REAL TIME READINGS UNDER DIRECTION OF VIBRATION
- 8. ALL MONITORING DATA SHALL BE PRESENTED TO THE CONSTRUCTION MANAGER AND ENGINEER AT THE END OF EACH DAY AS APPLICABLE.
- 9. LOCATIONS OF ALL SURVEY POINTS AND VIBRATION STATIONS ARE NOT SPECIFIED UNDER THESE DRAWINGS AND SHALL BE BY SURVEYOR/MONITORING CONTRACTOR.

LANDMARK STRUCTURE NOTES:

- 1. LANDMARK STRUCTURES ARE WITHIN 90'-0" OF THE CONSTRUCTION SITE.
- 2. AS SUCH, THE RULES OF TECHNICAL POLICY AND PROCEDURE (TPPL) NOTICE #10/88 SHALL BE ADHERED TO
- 3. CONTRACTOR MUST TAKE CARE AND PRECAUTION DURING EXCAVATION IMMEDIATELY ADJACENT TO LANDMARK STRUCTURES. MEANS AND METHODS IMPLEMENTED MUST ENSURE MINIMAL VIBRATIONS ARE TRANSFERRED TO
- 4. MINIMALLY LINE DRILLING OPERATIONS MUST BE PERFORMED FOR ROCK REMOVAL. IF ROCK IS FOUND TO BE VERY HARD, CHANNEL DRILLING MAY BE REQUIRED TO BE IMPLEMENTED TO AVOID EXCESSIVE CHOPPING OF
- 5. VIBRATION MONITORS/SEISMOGRAPHS SHALL BE INSTALLED ADJACENT TO AREAS WHERE WORK IS TO BE PERFORMED. LANDMARK STRUCTURES SHALL BE. 5.1. THE MAXIMUM PERMISSIBLE PEAK PARTICLE VELOCITY (PPV) SHALL BE 0.5 IN/SEC. SENSITIVITY OF
- SEISMOGRAPHS SHALL BE SET TO 0.4 IN/SEC FOR NOTIFICATION IN ORDER TO PROPERLY ADDRESS OR MODIFY MEANS AND METHODS AS NECESSARY. 5.2. MAX PPV MAY BE REDUCED IF MOVEMENTS AND/OR CRACKING IS DETECTED IN ADJ. BUILDING.
- MANAGER AND ENGINEER (REGULAR SURVEY MONITORING DATA SHALL BE AVAILABLE TO DESIGN TEAM REGULARLY). LICENSED SURVEYOR MUST DETERMINE IF MEASURED MOVEMENT IS NOT ATTRIBUTED TO SURVEYING TOLERANCES PRIOR TO ALERT NOTIFICATIONS.

6. IF THE MOVEMENT OF THE BUILDING IN ANY OF THE 3-AXIS REACHES 3/16 INCH, NOTIFY THE CONSTRUCTION

6.1. THE MAXIMUM PERMISSIBLE MOVEMENT IN ANY OF 3-AXIS SHALL BE 1/4 INCH. 7. FREQUENCY OF MONITORING WILL VARY DURING PROGRESS OF WORK, HOWEVER SURVEY MEASURES ON

LANDMARK STRUCTURES SHALL BE MADE AT MINIMUM TWO (2) TIMES PER WEEK.

TO THE BEST OF OUR OFFICE'S KNOWLEDGE, THERE ARE TWO (2) DESIGNATED LANDMARK STRUCTURES THAT IS WITHIN 90 FEET OF THE EXTENTS OF THE PROJECT SITE LIMITS.

RECTORY OF THE CHURCH OF THE TRANSFIGURATION ADDRESS: 1 EAST 29 STREET

BOROUGH: MNBLOCK: 859 LOT: 5 LP NUMBER: LP-00471 DESIGNATED: MAY 25, 1967 STATUS: DESIGNATED

CHURCH OF THE TRANSFIGURATION ADDRESS: 3 EAST 29 STREET BOROUGH: MNBLOCK: 859 LOT: 6 LP NUMBER: LP-00470 DESIGNATED: MAY 25, 1967

STATUS: DESIGNATED

- SPECIAL INSPECTIONS REQUIRED UNDER THESE DRAWINGS:
- 1. EXCAVATION: SHEETING, SHORING, BRACING (BC 1704.20.2) 2. UNDERPINNING (BC 1704.20.3, BC 1814)
- 3. STRUCTURAL STABILITY EXISTING BUILDINGS (BC 1704.20.1) 4. CONCRETE TEST CYLINDERS (BC 1905.6, BC 1913.10)

5. CONCRETE DESIGN MIX (BC 1905.3, BC 1913.5)

ENERGY CODE: TO THE BEST OF THIS OFFICE'S KNOWLEDGE, BELIEF AND PROFESSIONAL JUDGEMENT, ALL WORK UNDER THIS APPLICATION IS IN COMPLIANCE WITH THE NYCECC 2010.

COORDINATION NOTE:

ALL WORK TO BE PERFORMED SHALL BE COORDINATED BETWEEN THE CONTRACTOR AND APPLICABLE UTILITY COMPANIES AND/OR CITY DEPARTMENTS AS REQUIRED.




Z

UPDATED DOB PAGES 05/17/2016 UPDATED FND 05/11/2016 04/21/2016 REVISED SOE AT SIDEWALK VAULT (RAMP) REVISED SOE 04/20/2016 AT SIDEWALK VAULT 03/23/2016 DOB SUBMISSION 03/14/2016 REVISED SOE PRELIM SOE 03/07/2016 No: Revision: Date: SCALE: AS NOTED EAST 30TH STREET BLOCK 859 <u>OT 85, 86</u> <u>& 87</u> EAST 29TH STREET E 29 ST


DRAWING TITLE:

GENERAL NOTES

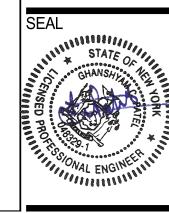



03-07-2016 PROJECT No: ¹Drawn Bv.



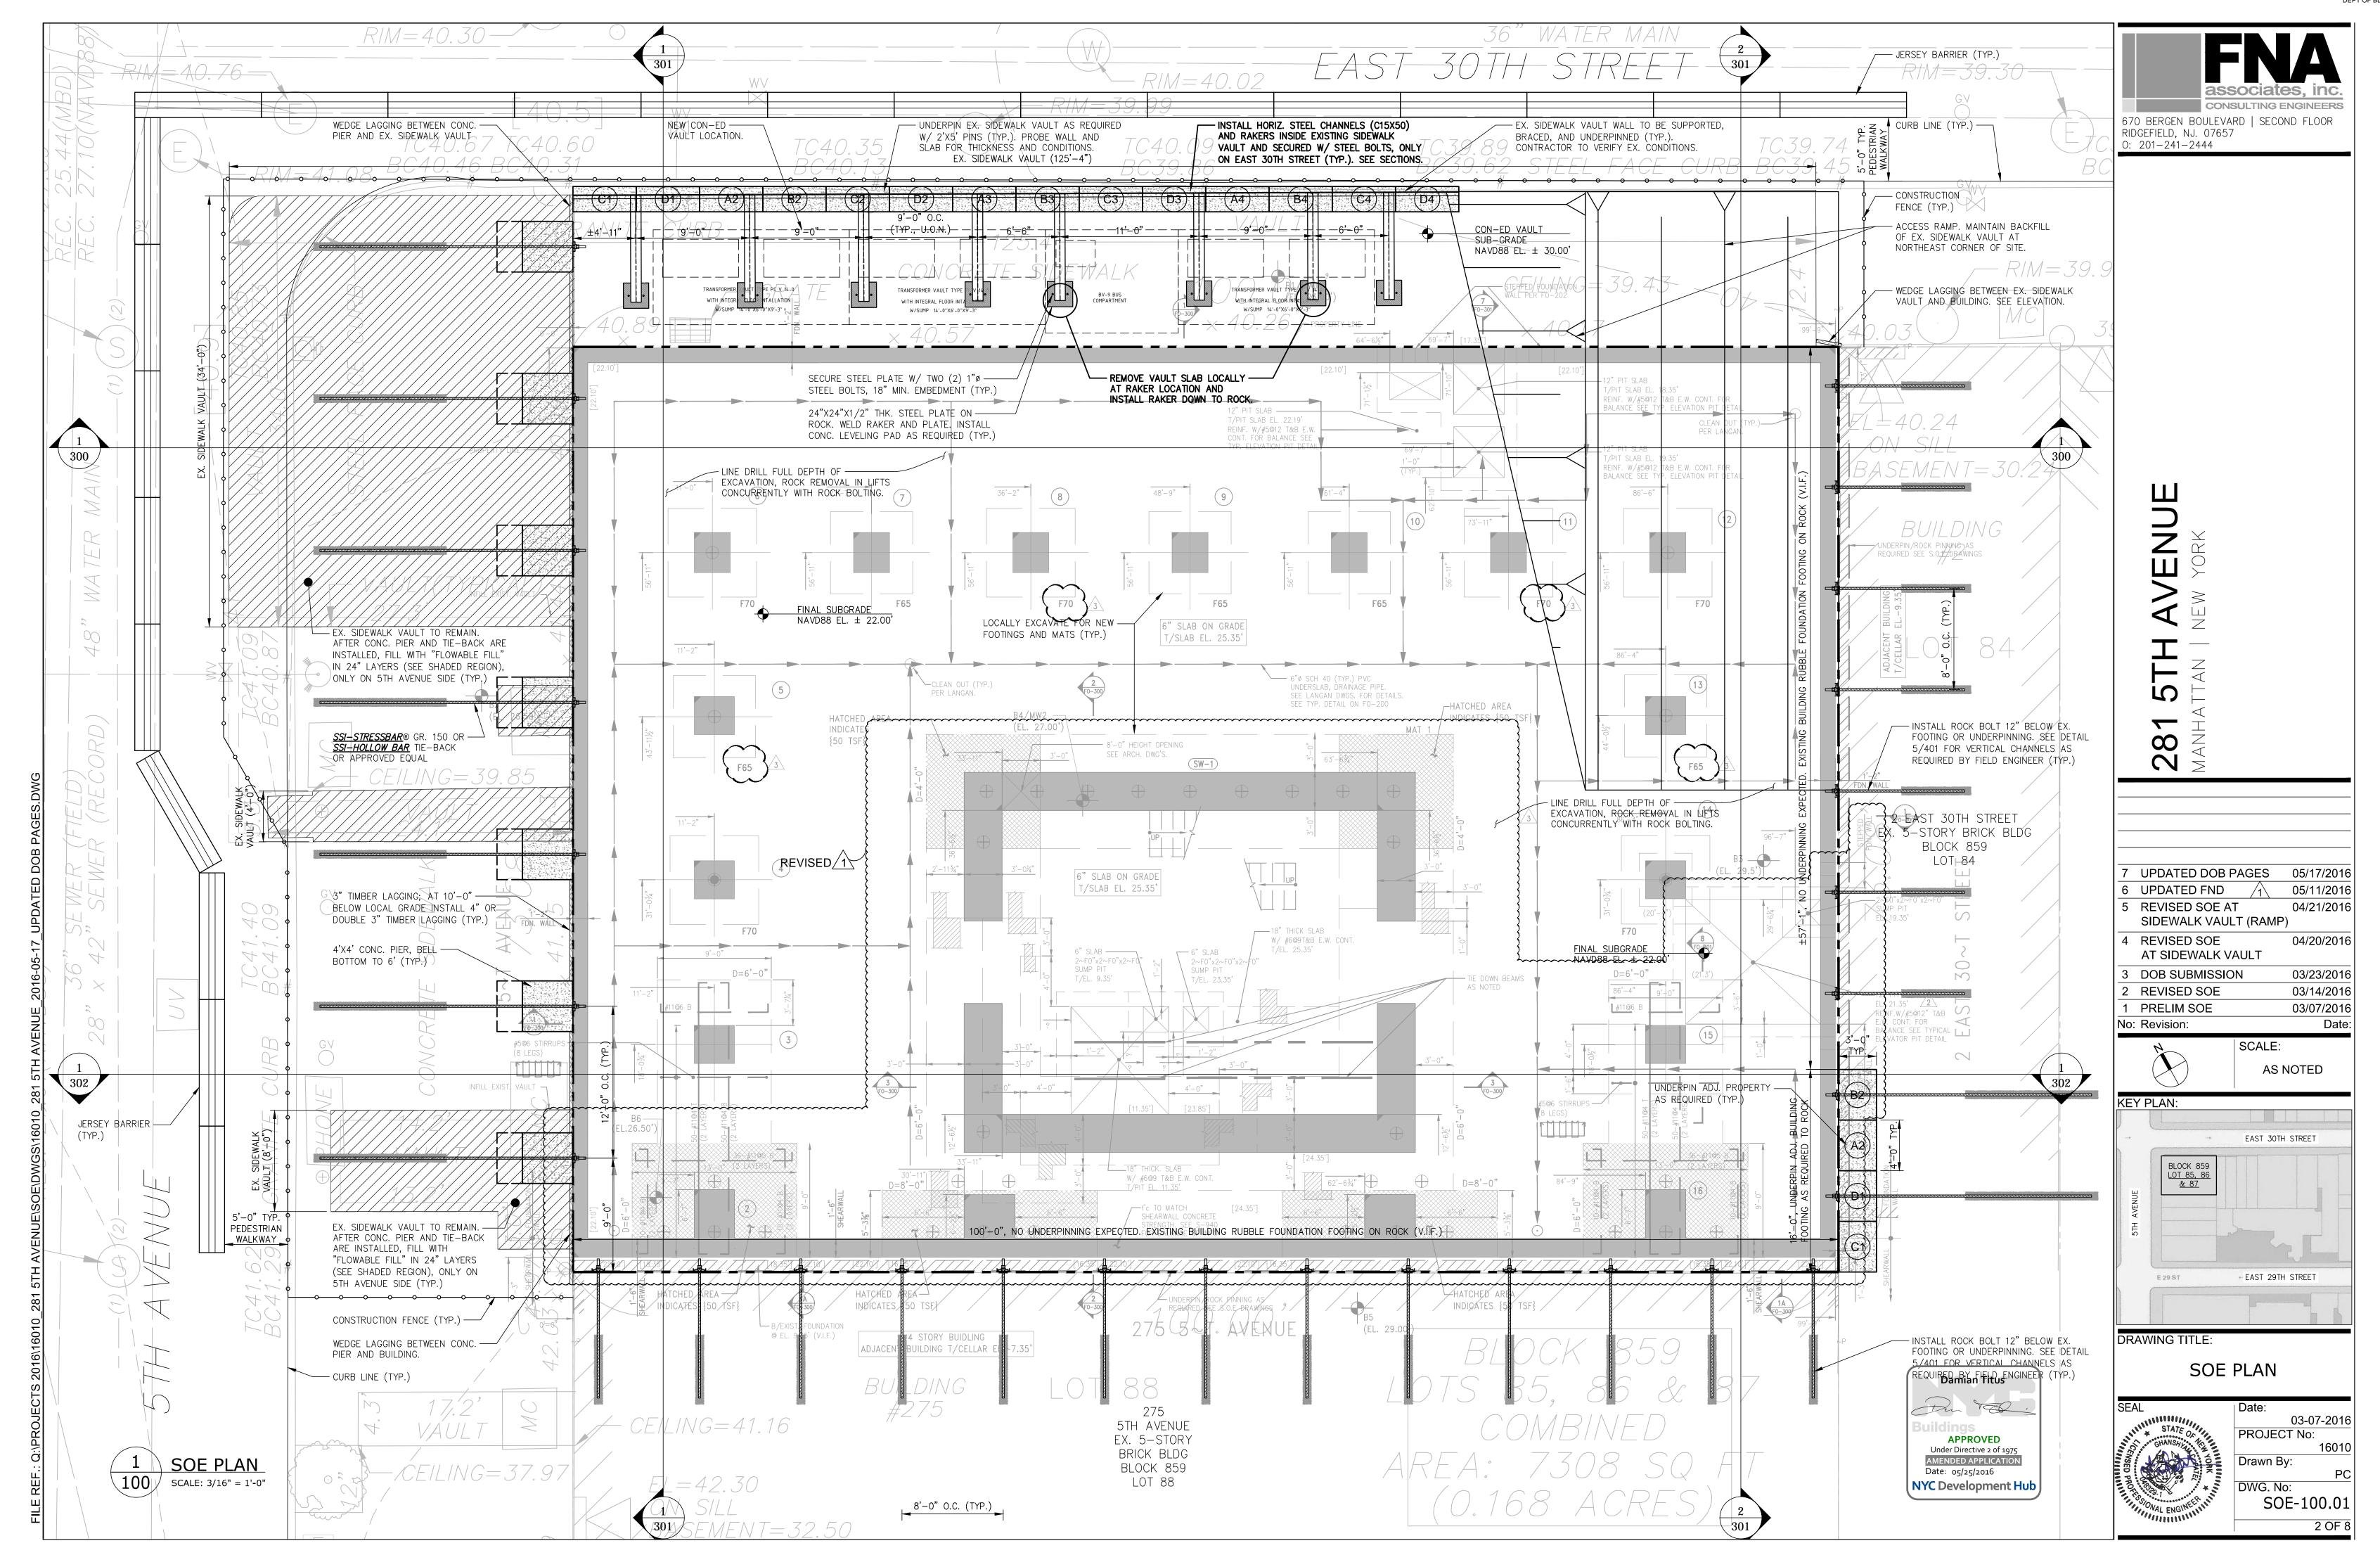



Superseded 6-8-2016

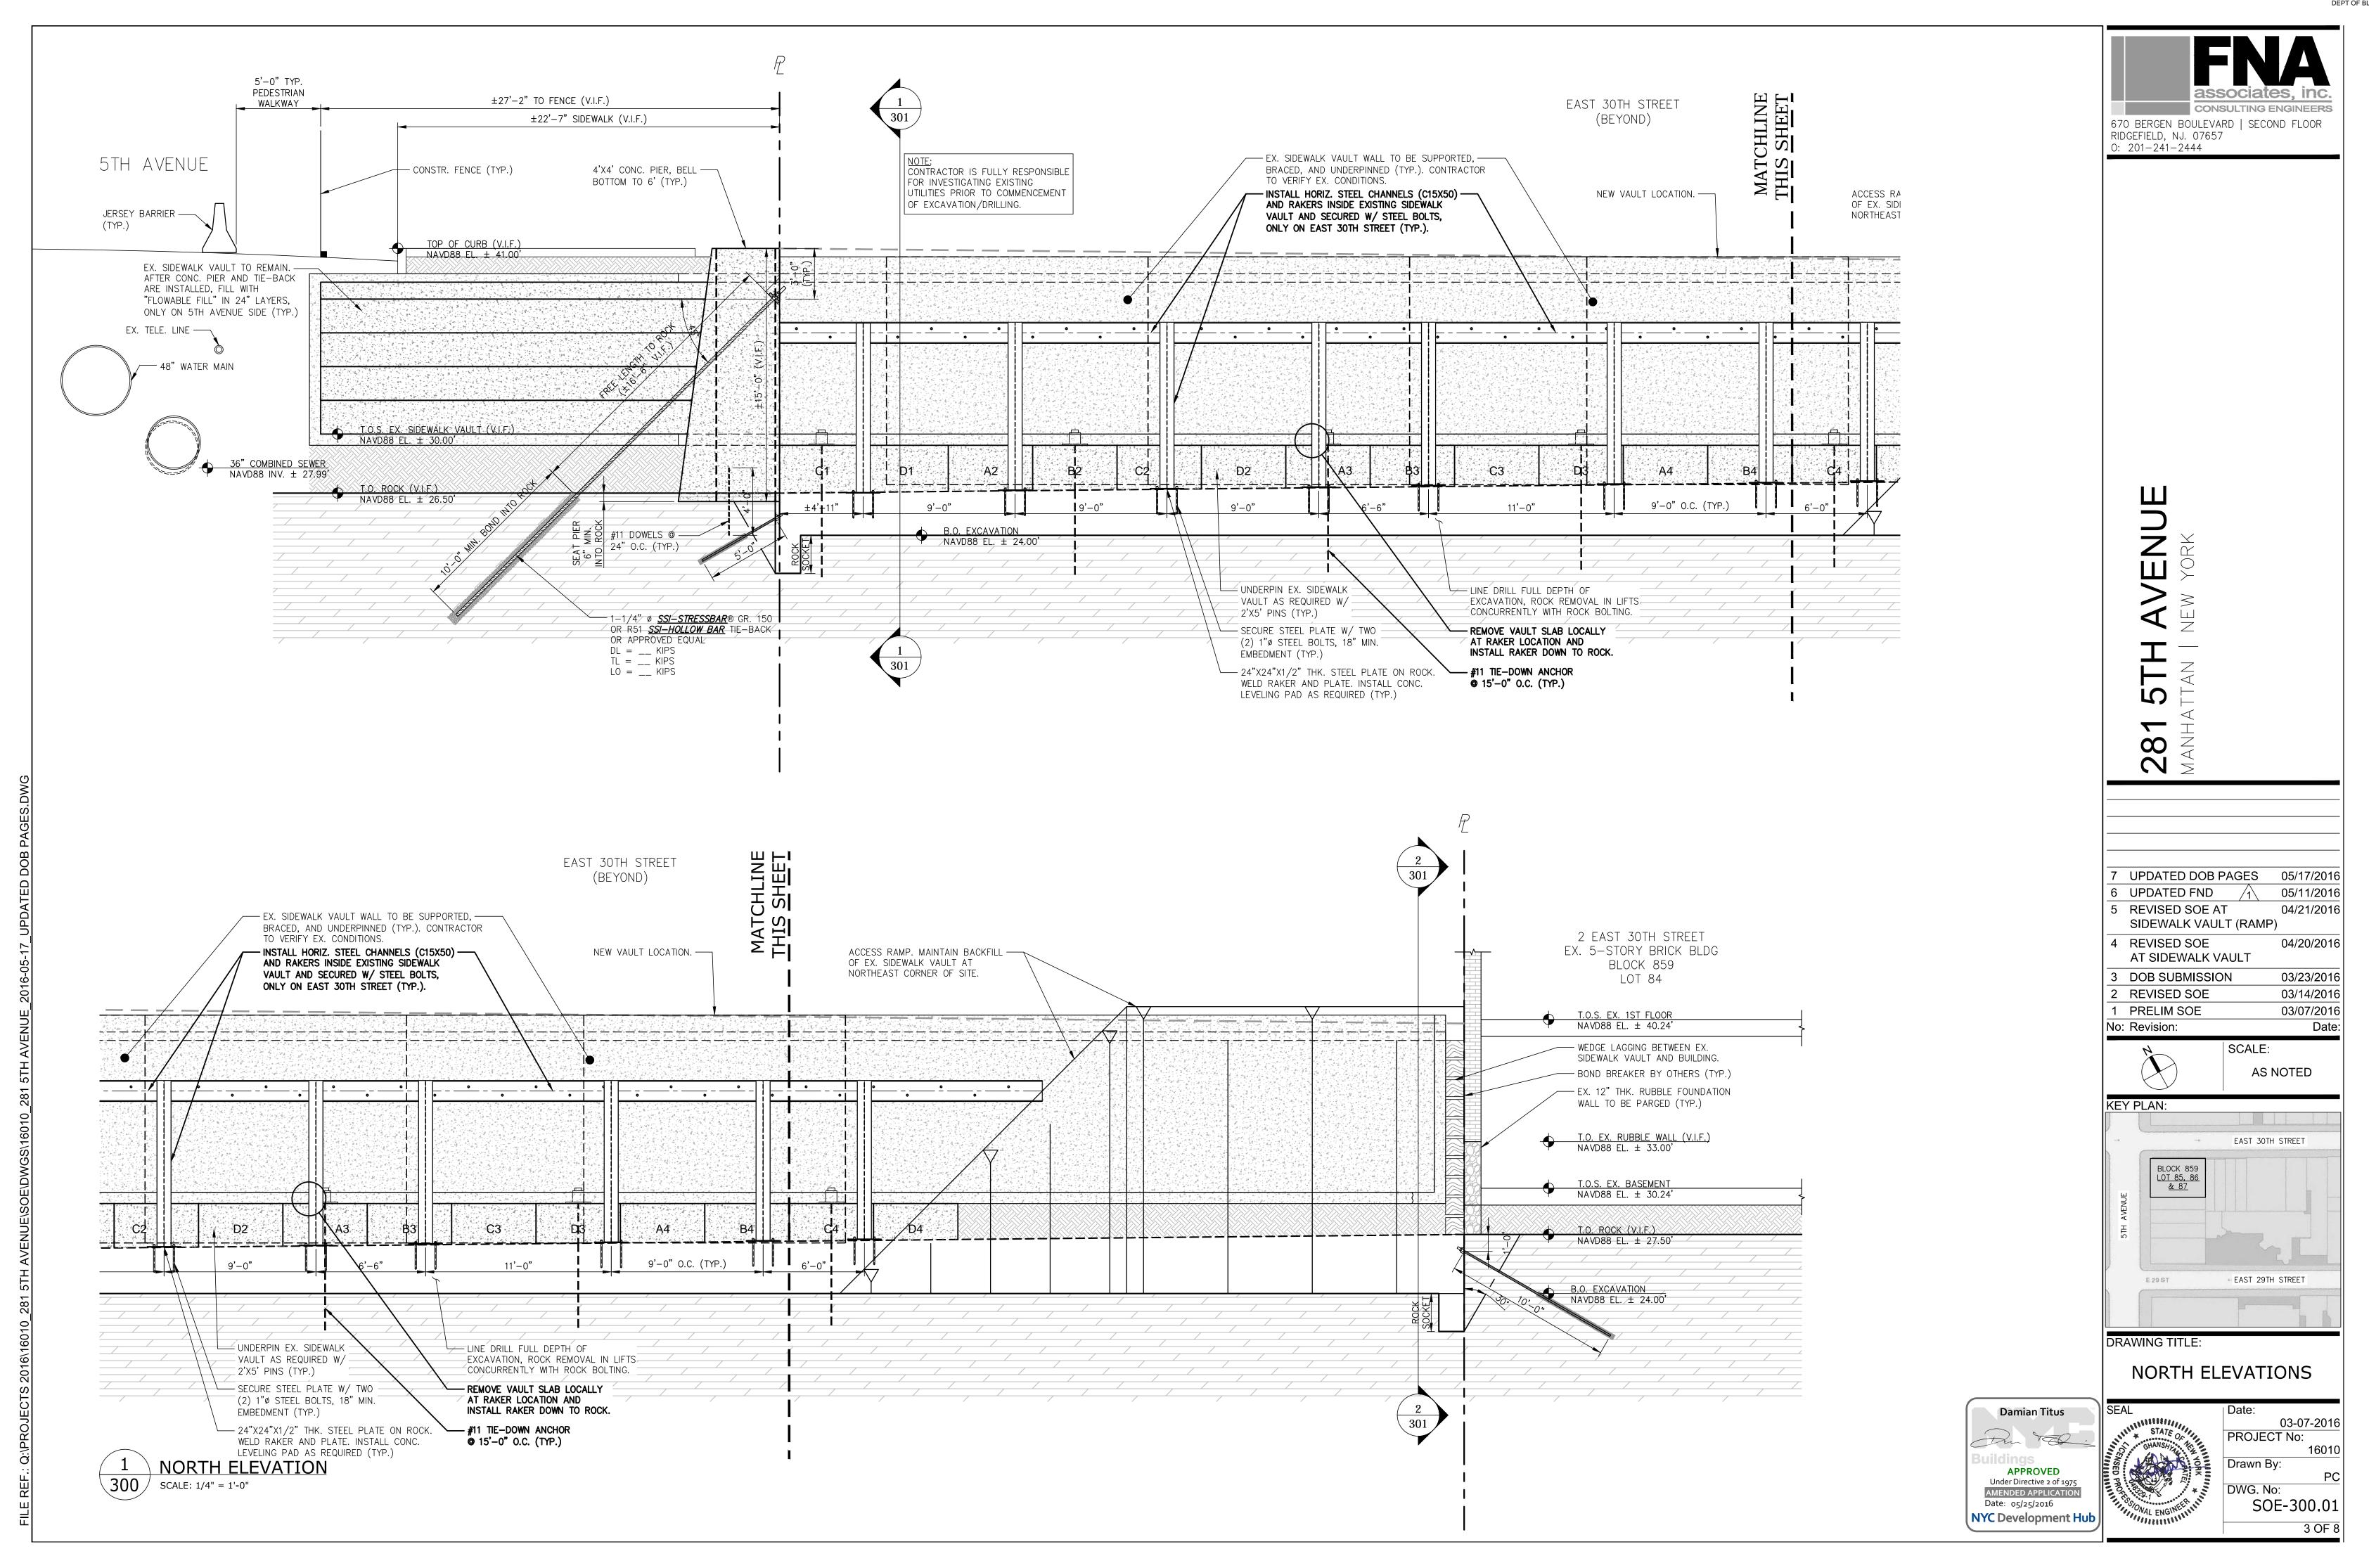


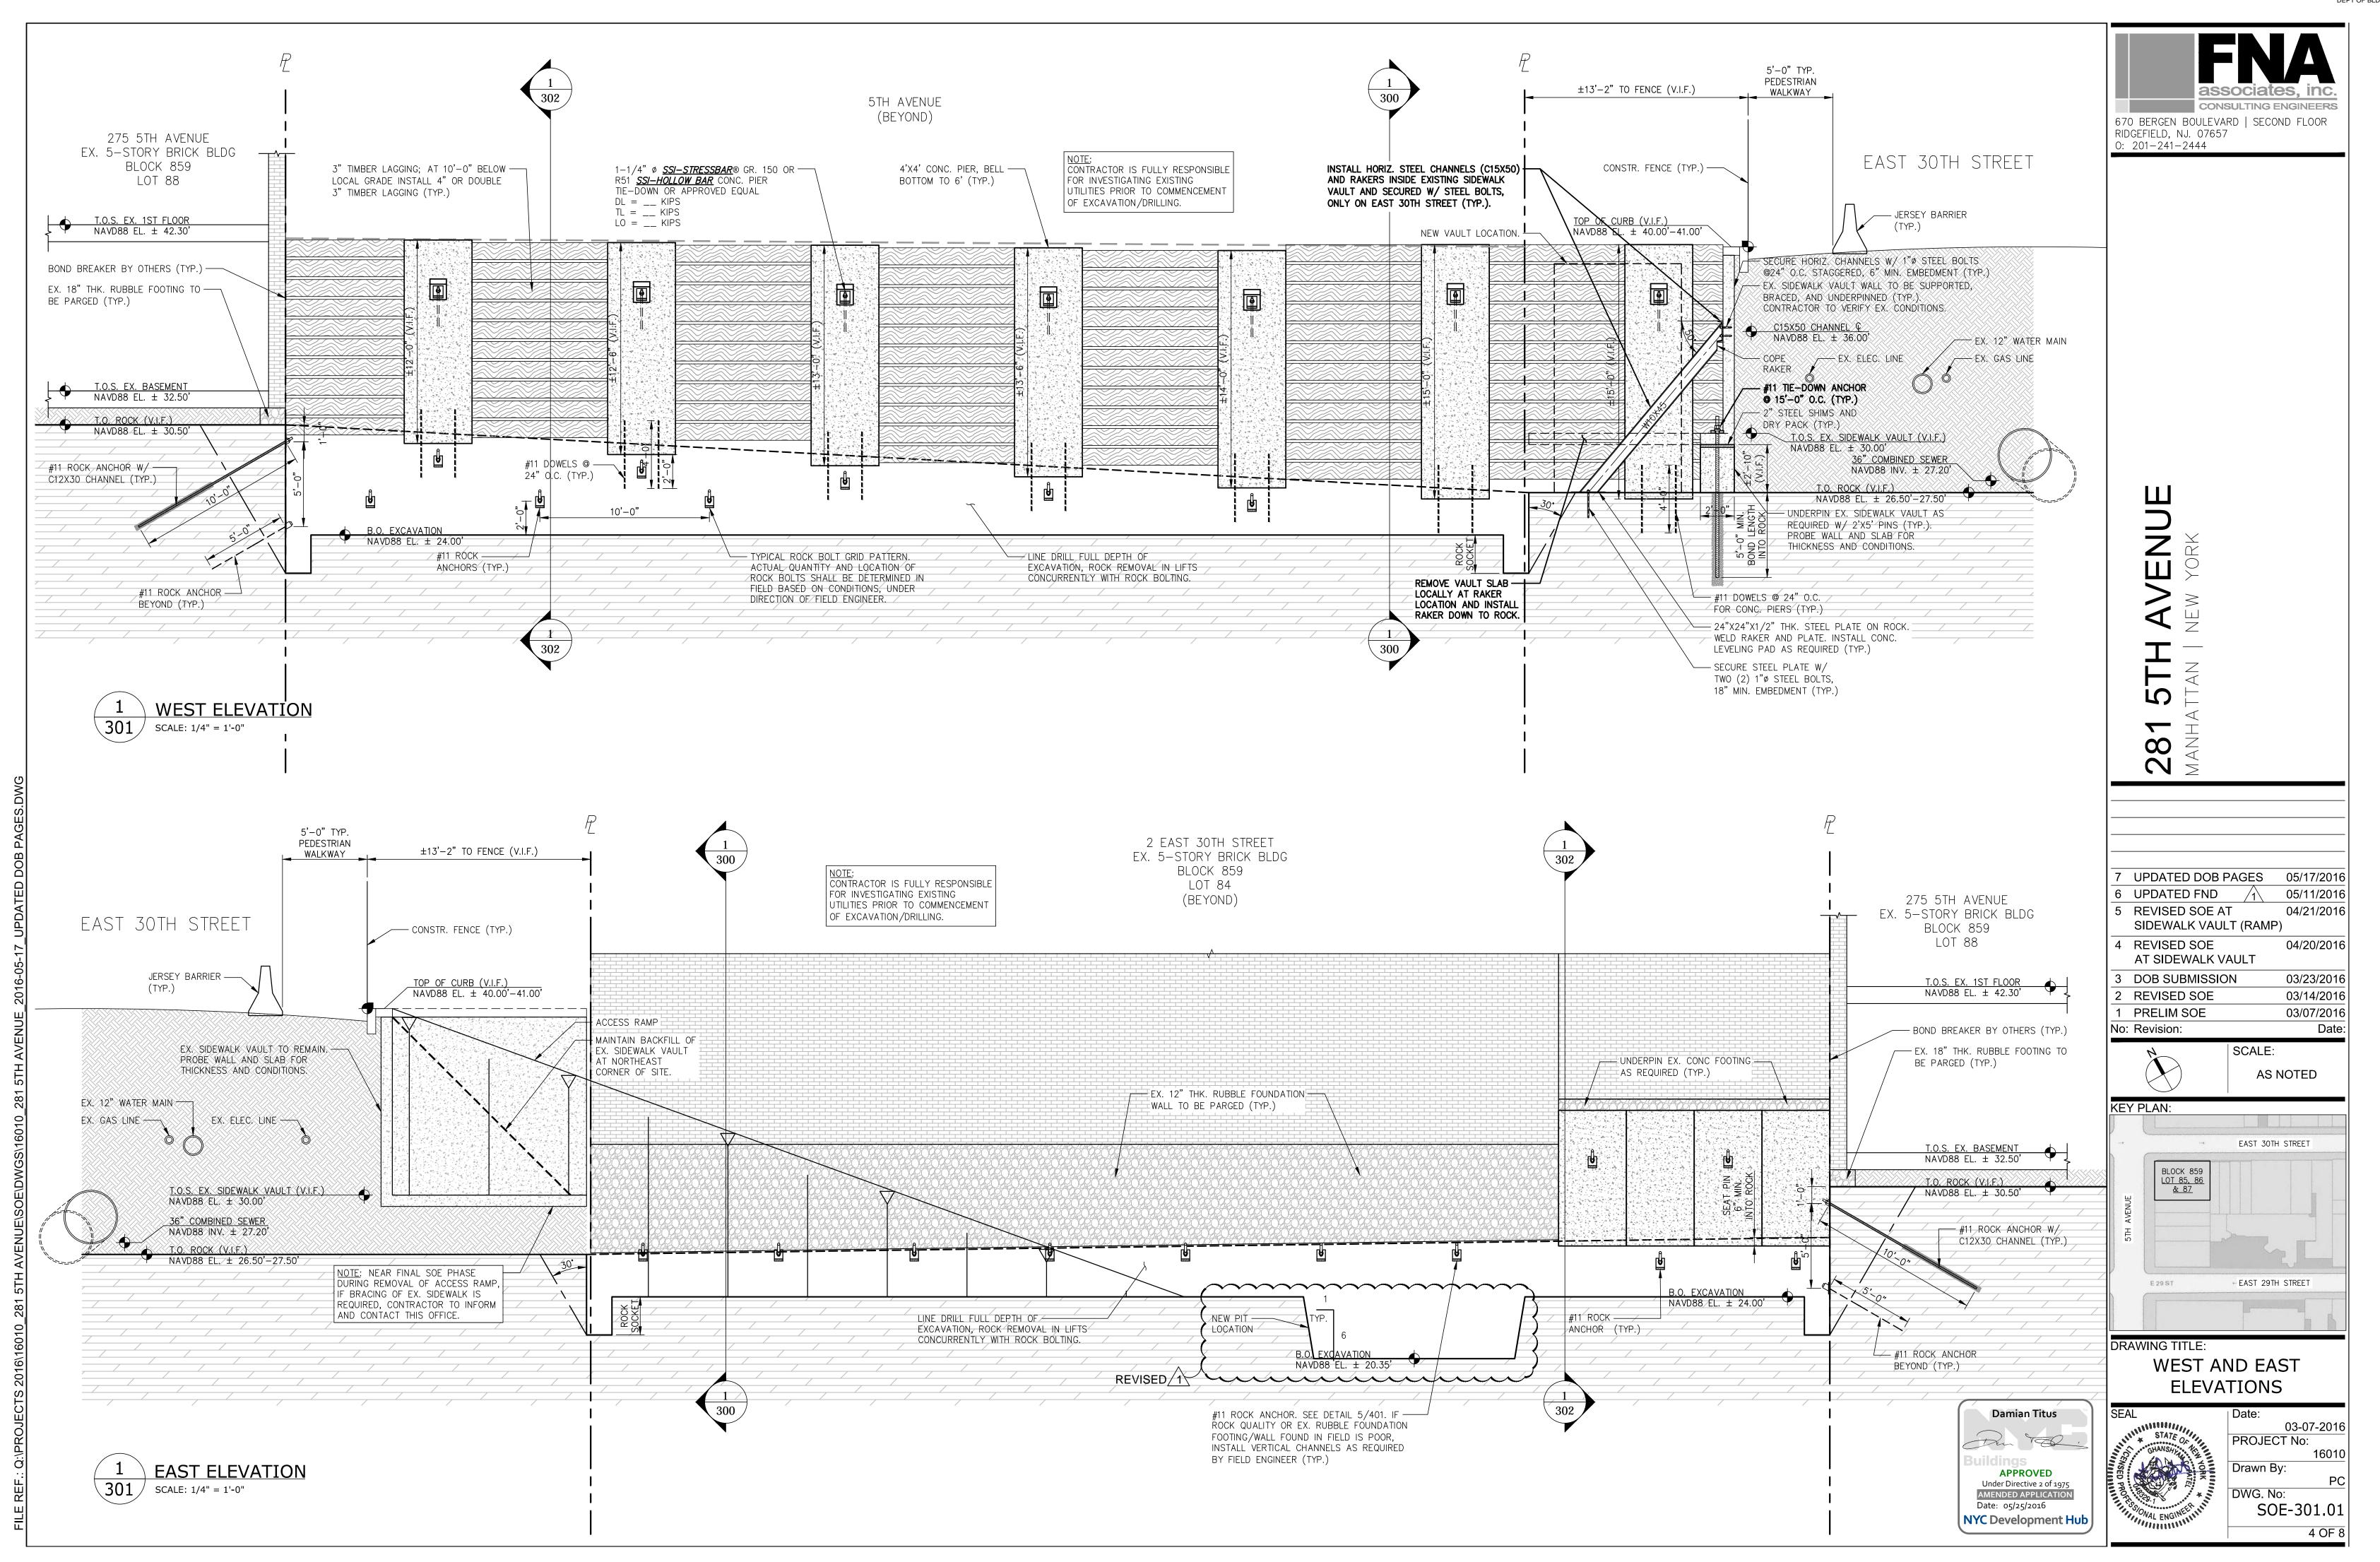


Superseded 6-8-2016

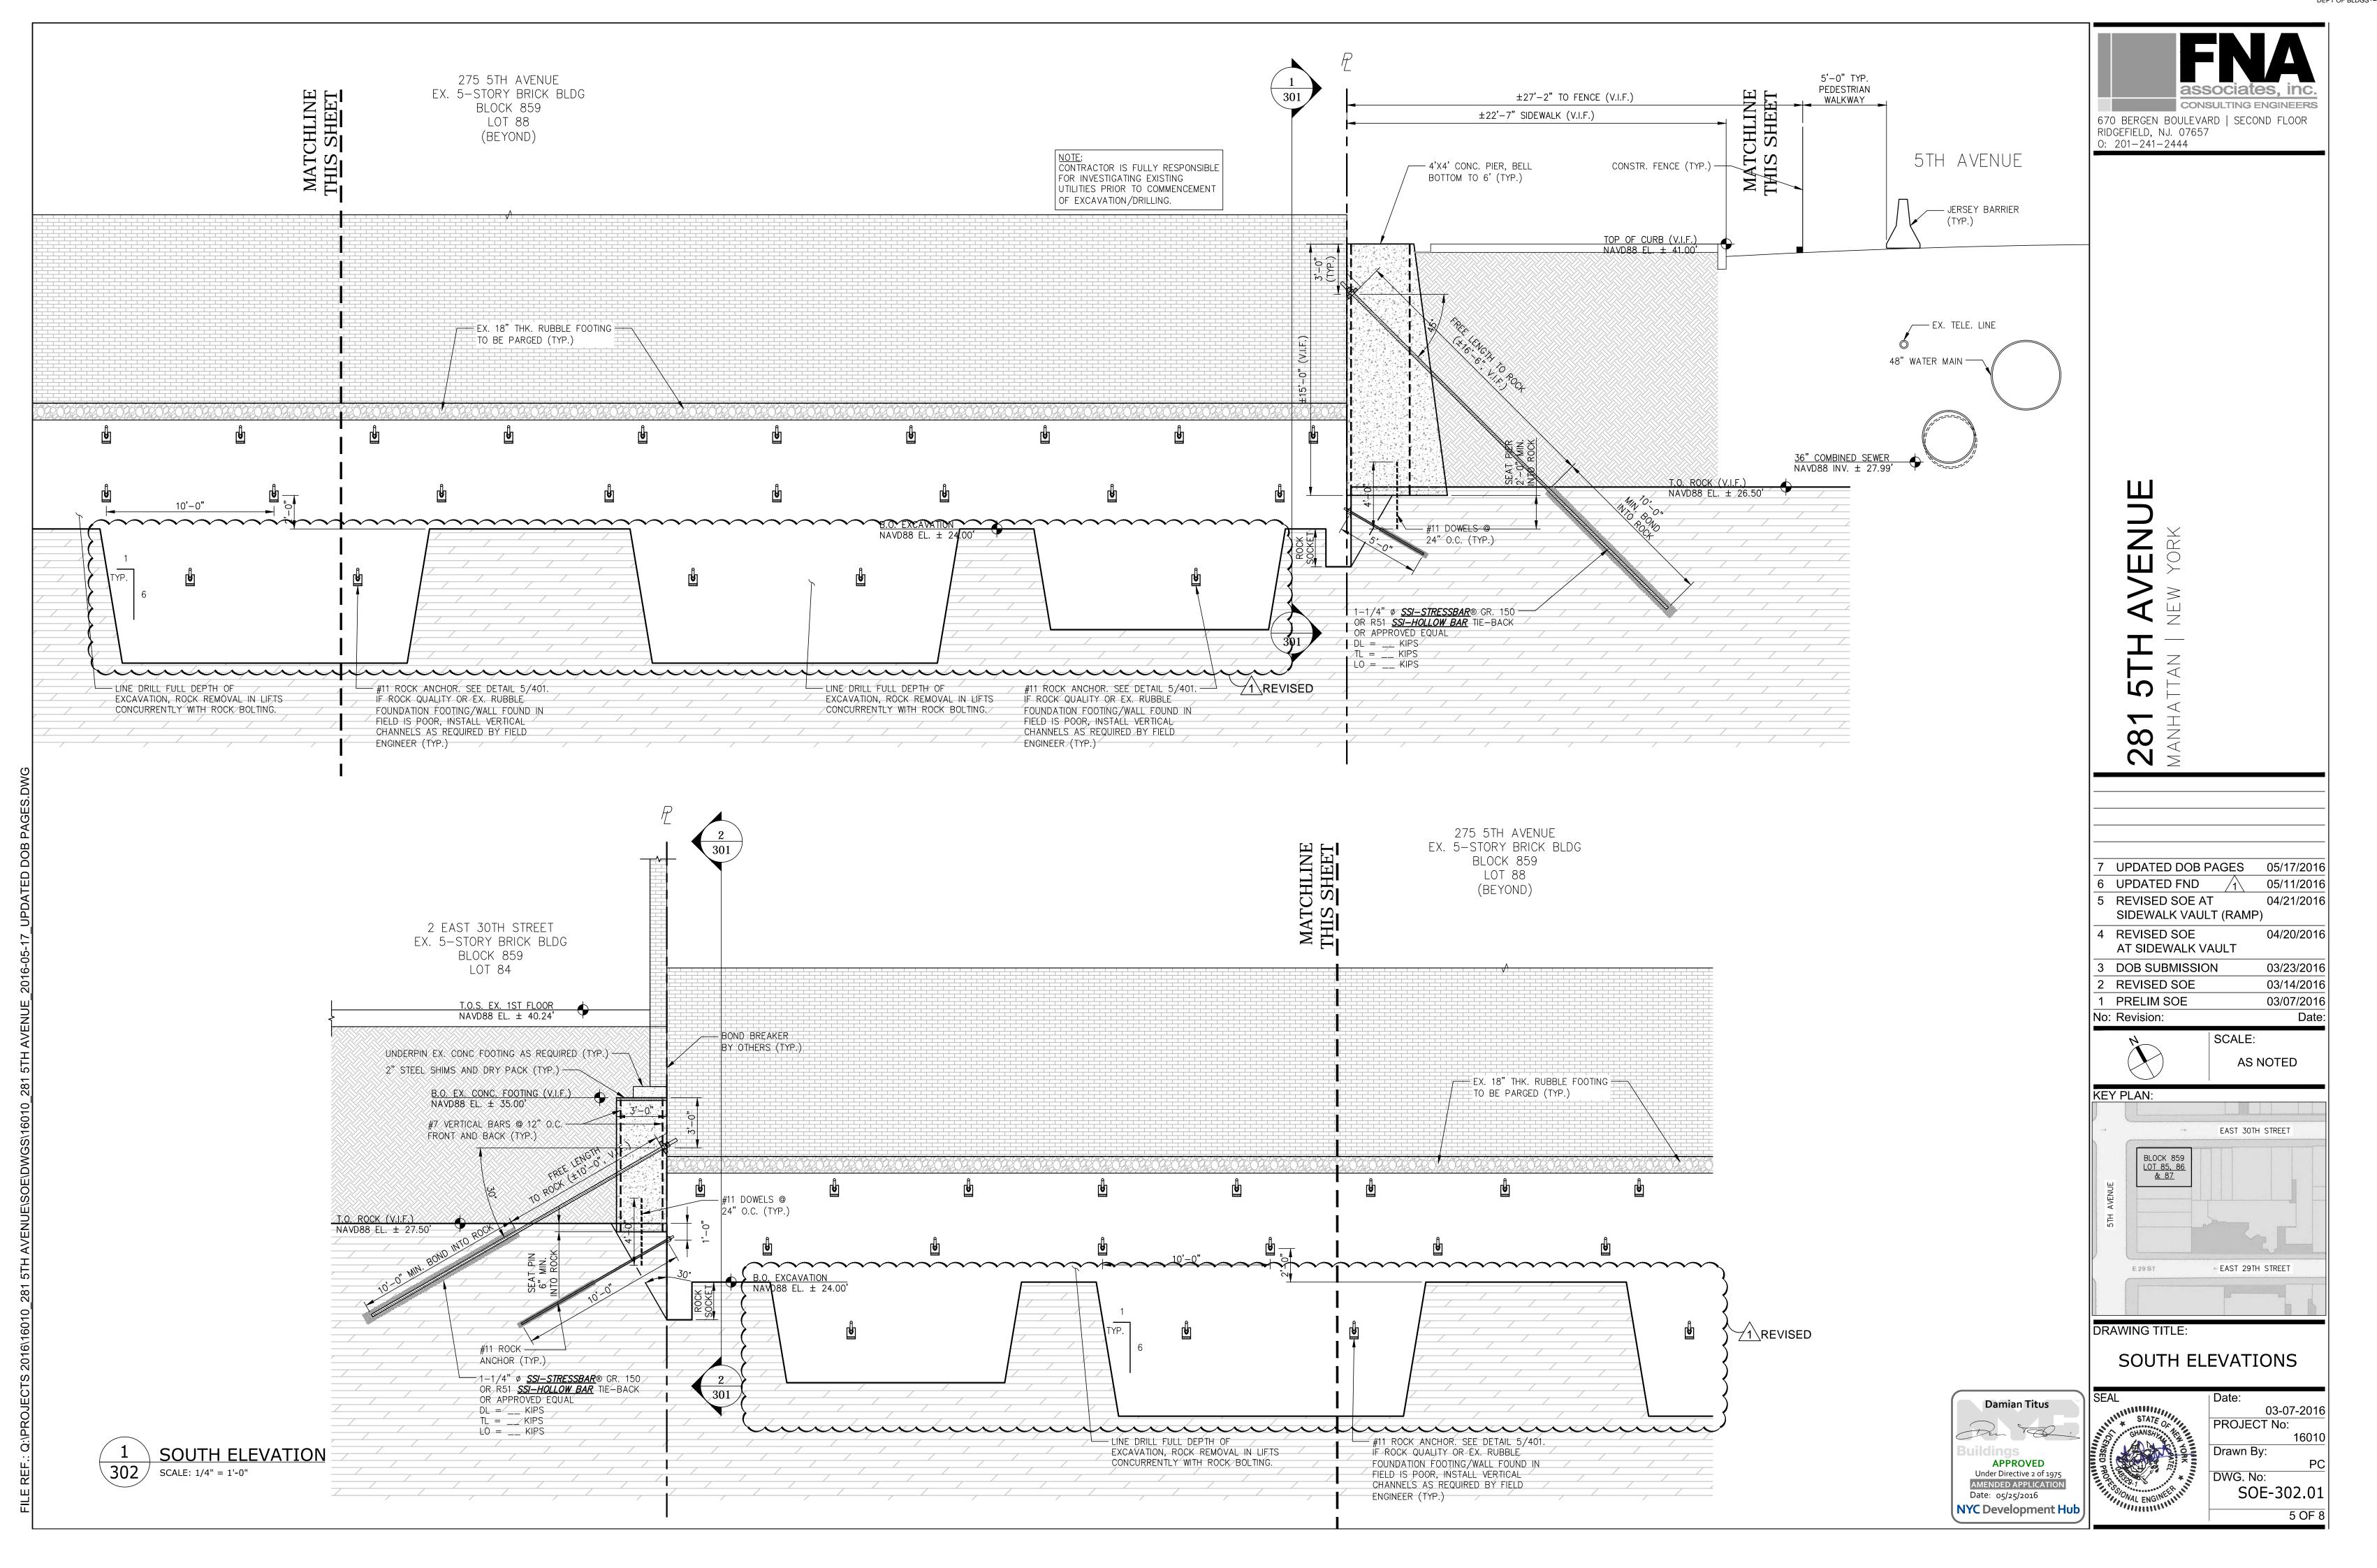

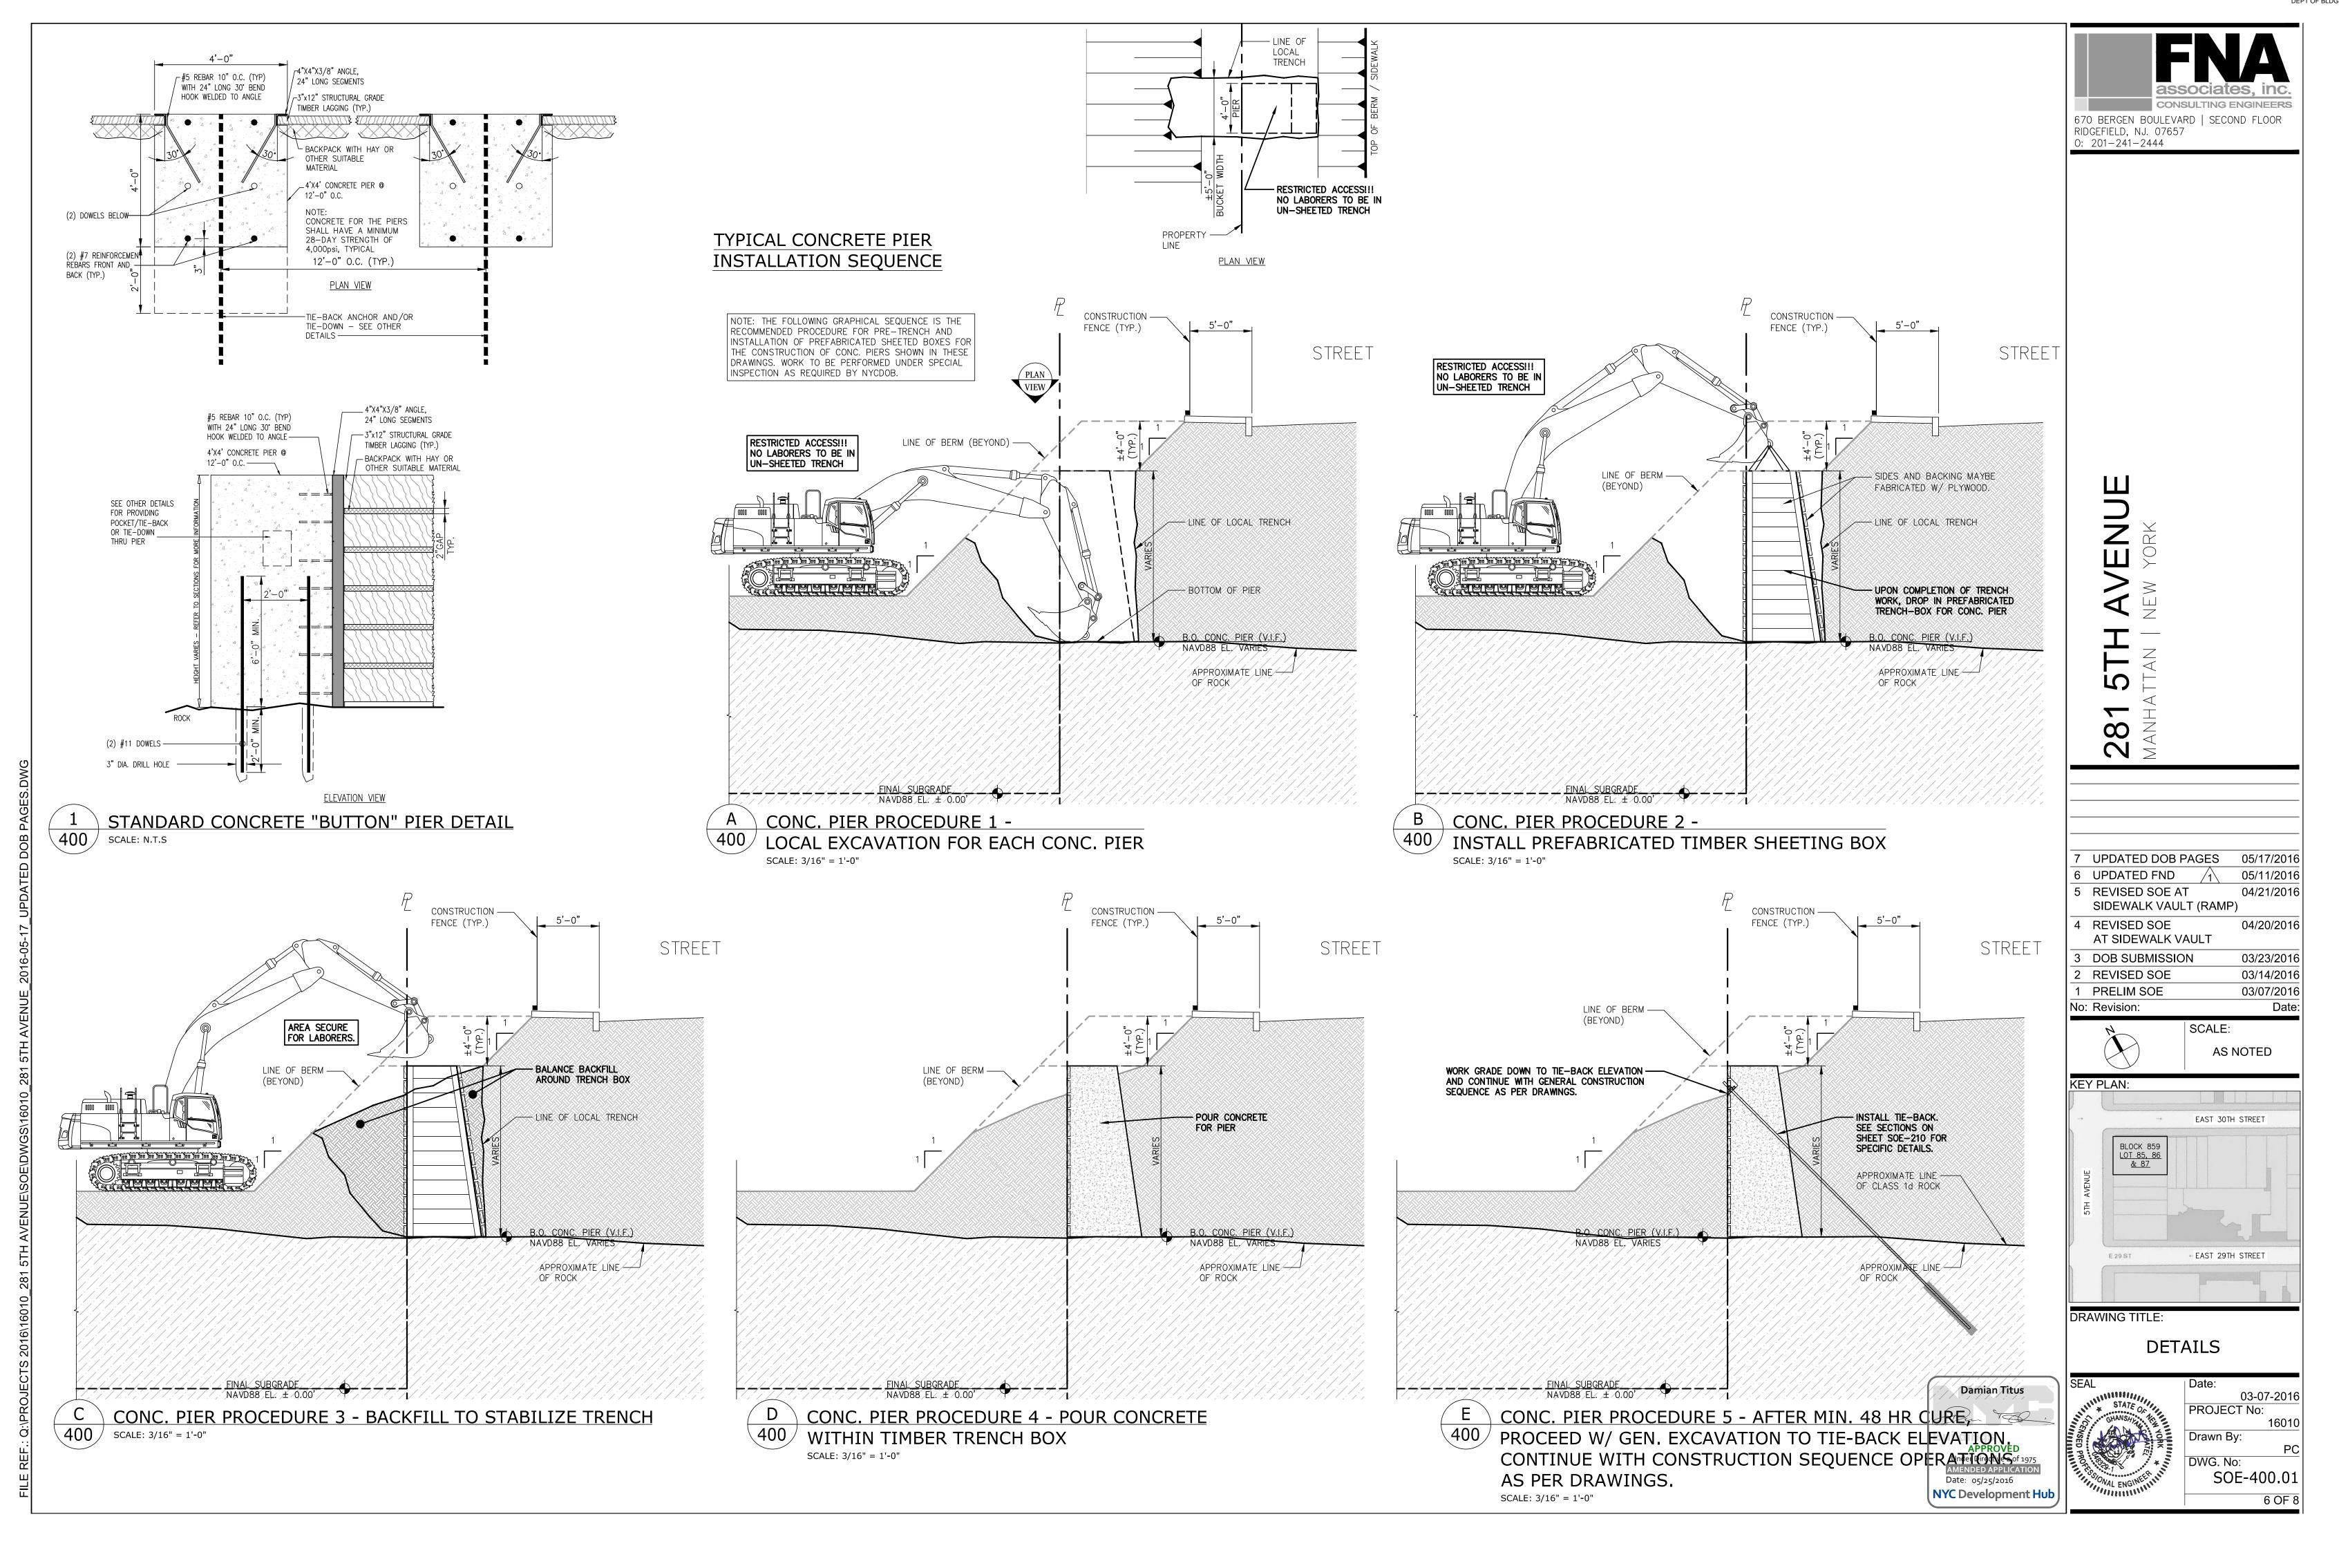

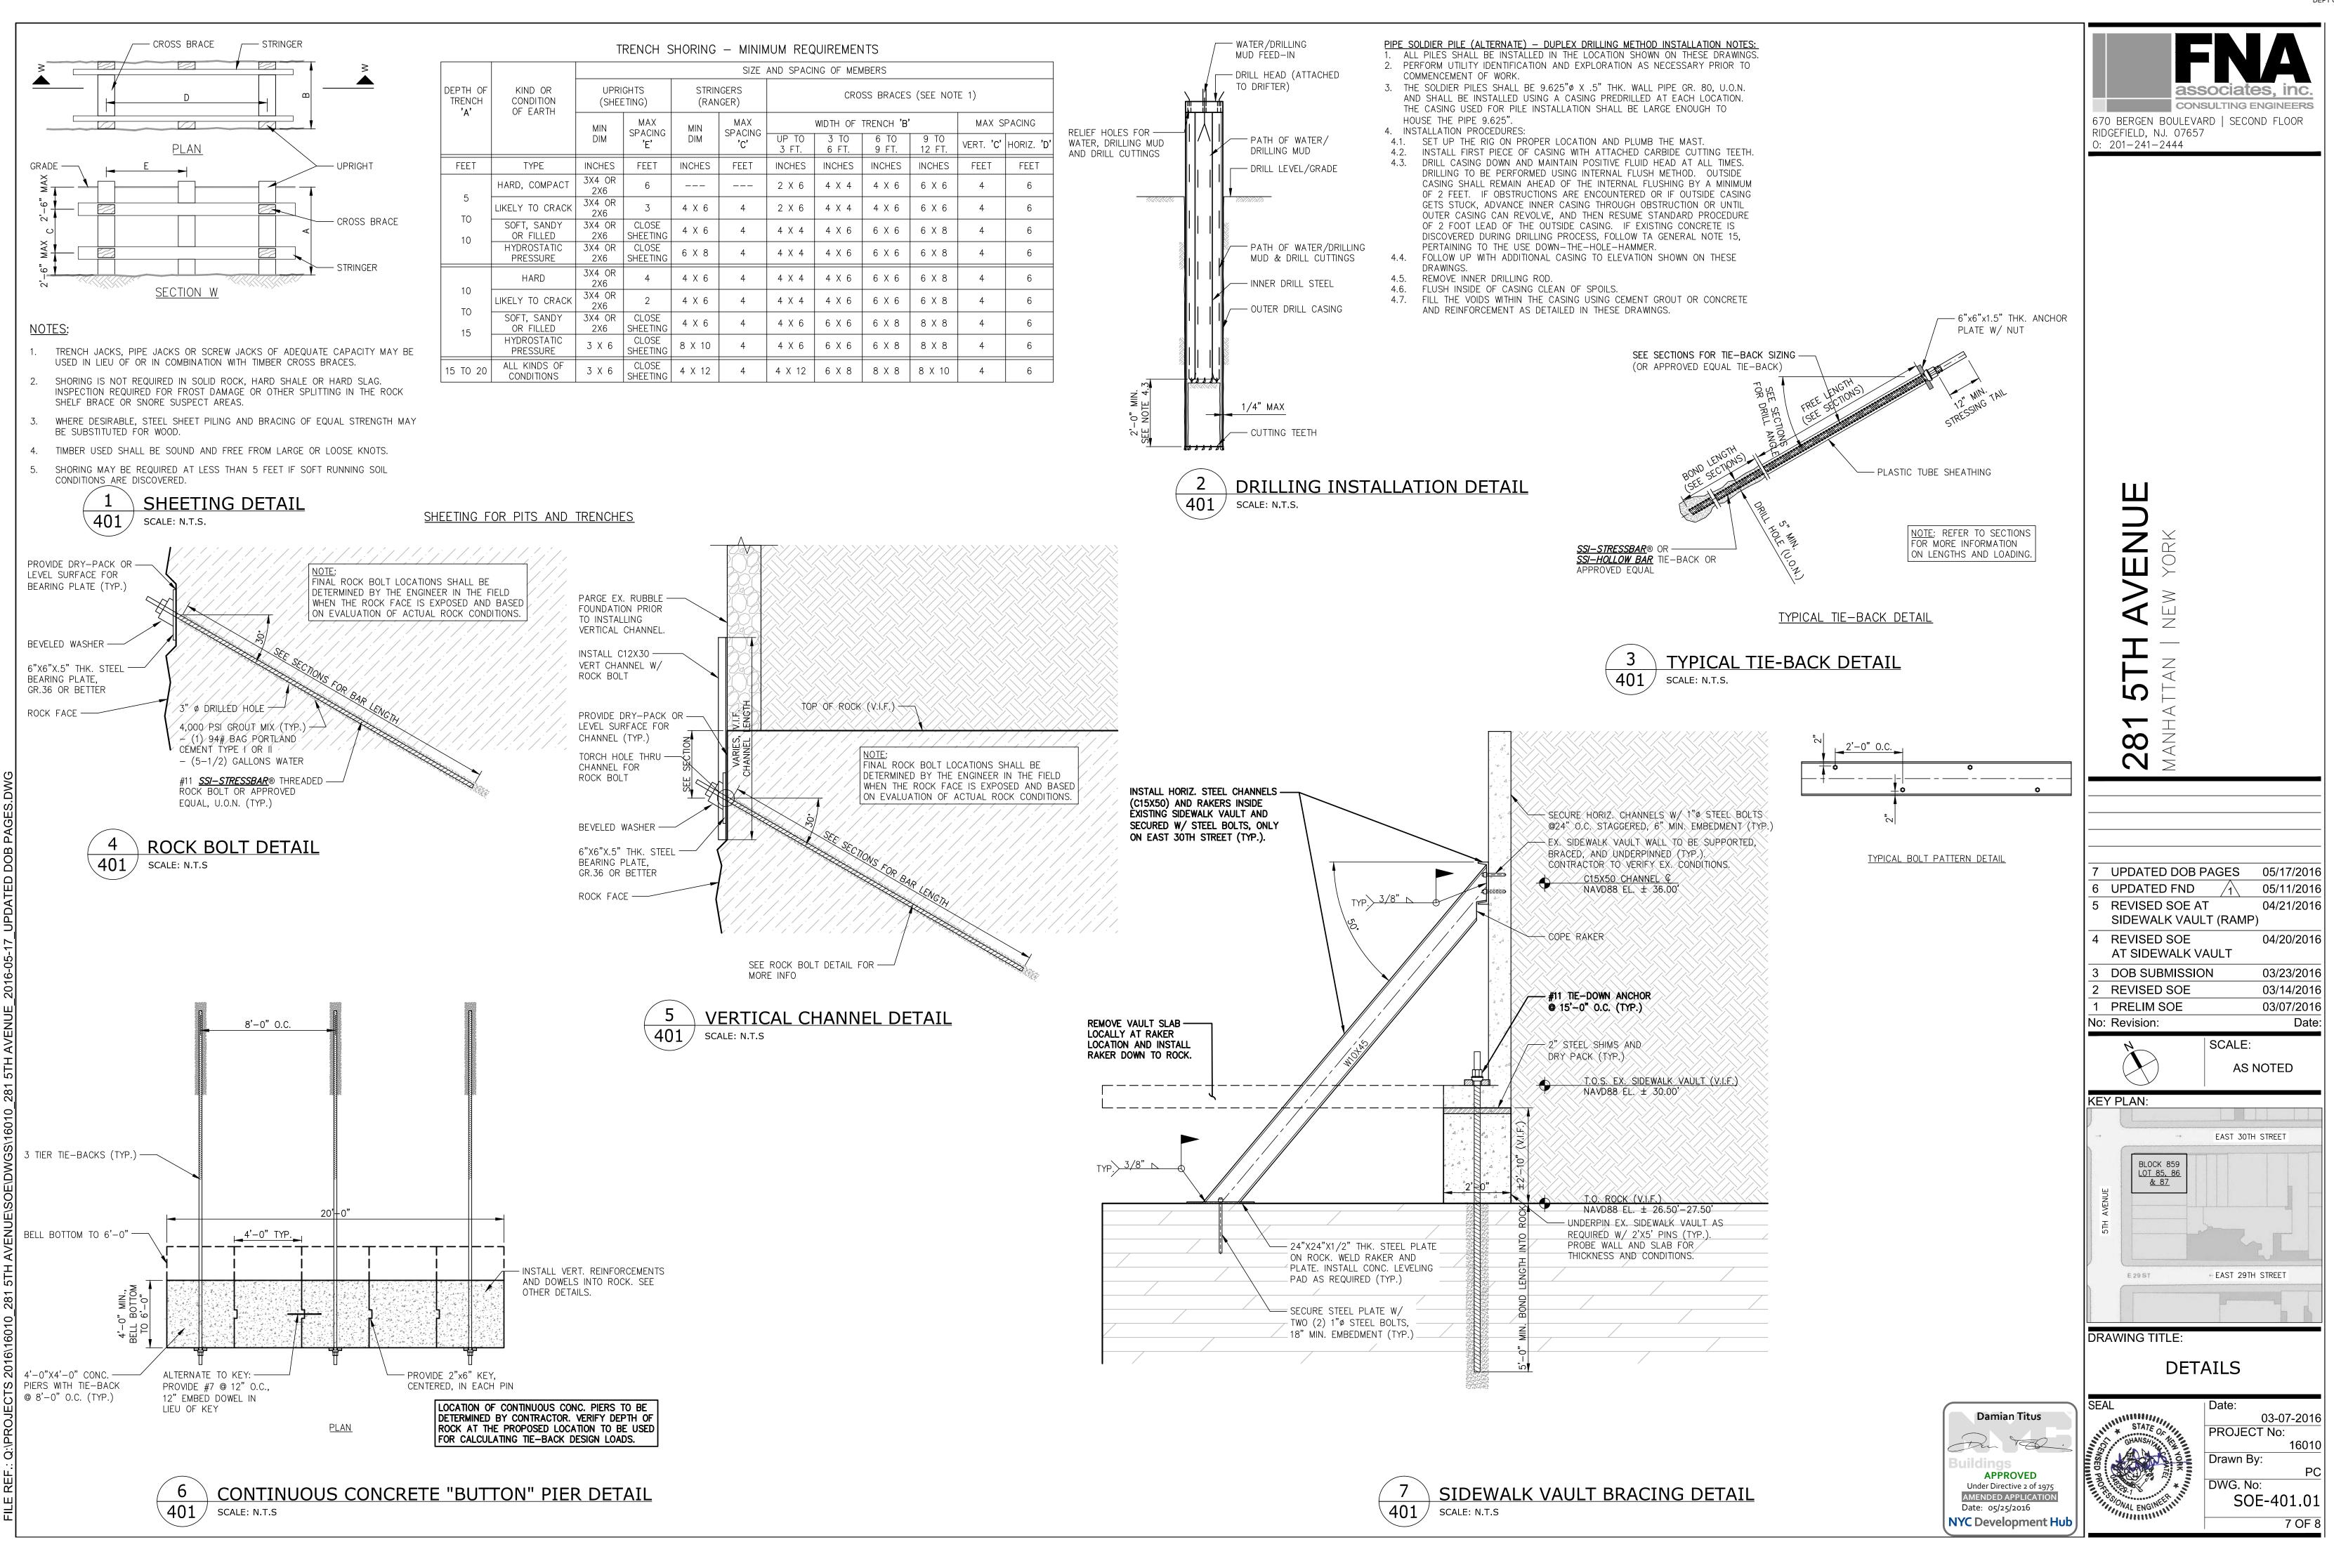

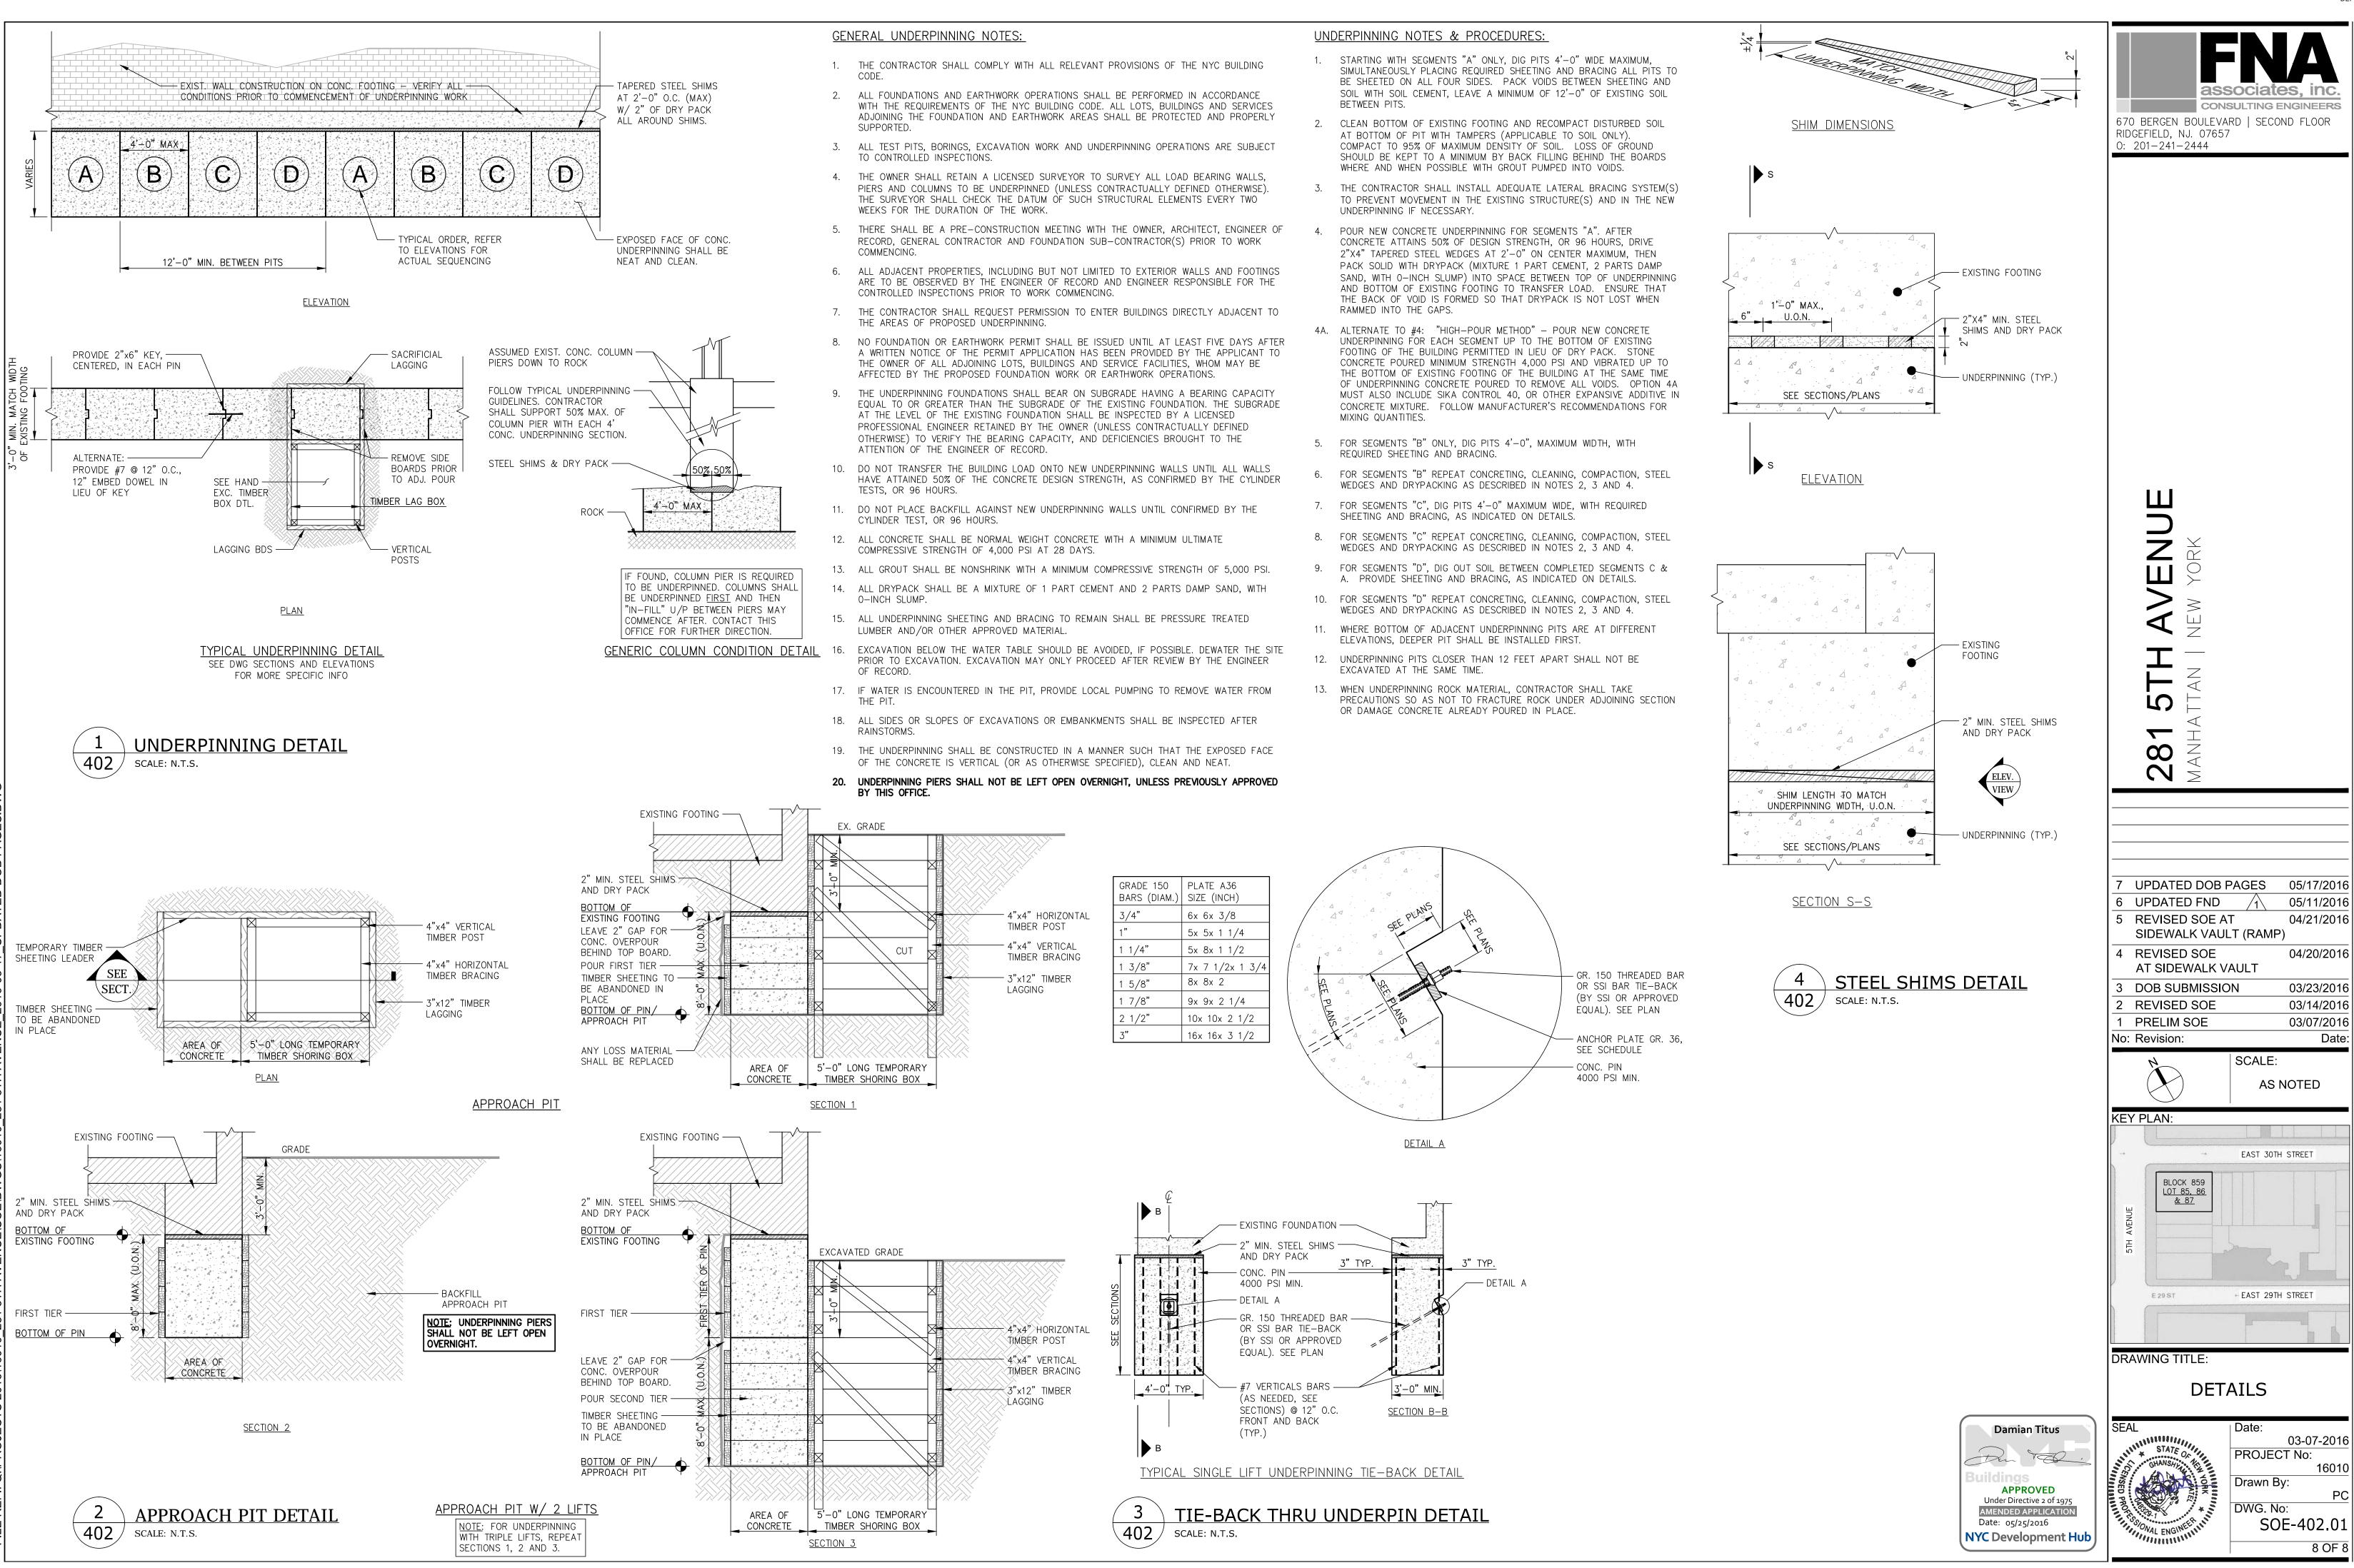

ABBREVIATIONS: ANCHOR BOLT JOINT ABV ABOVE AIR CONDITIONER KIP (1000 POUNDS) AMERICAN CONCRETE INSTITUTE KPF KIPS PER SQUARE FOOT ADD'L ADDITIONAL KIPS PER SQUARE INCH ADJACENT LINK BEAM ABOVE FINISHED FLOOR POUNDS AMERICAN INSTITUTE OF STEEL CONSTRUCTION LB/FT POUNDS PER FOOT ALTERNATE ALUM ALUMINUM DEVELOPMENT LENGTH ANCH ANCHOR LONG ANGLE LIVE LOAD APPROVED LATERAL LOAD RESISTING LLRS **APPROXIMATE** LONG LEG VERTICAL LLV ARCHITECTURAL LOW POINT ASTM AMERICAN SOCIETY FOR LRFD LOAD RESISTANCE FACTOR TESTING AND MATERIALS DESIGN AVFRAGE LIGHT AWS AMERICAN WELDING SOCIETY LIGHT WEIGH L.W. LONG WAY BETW BFTWFFN BRACE FRAME MAXMAXIMUM BRACKET MAS MASONRY BUILDING LINE MATER MATERIAL BUILDING MAXMAXIMUM BEAM MOMENT CONNECTION BOTT BOTTOM METAL DECK BRK BRICK MECH MECHANICAL B/STL BOTTOM OF STEE MECHANICAL ELECTRICAL BOTH SIDES AND PLUMBING MEZZ MEZZANINE CANT CANTILEVER MOMENT FRAME CUBIC FOOT MFG MANUFACTURER CENTER OF GRAVITY MIN MINIMUM CAST IN PLACE MISC MISCELLANEOUS CONCRETE JOIN CENTER LINE NORTH CEILING NOT APPLICABLE CLEAR NOT IN CONTRACT NIC CONSTRUCTION MANAGER NUMBER CONCRETE MASONRY UNITS NORTH-SOUTH N-SCOLUMN NOT TO SCALE NTS CONCRETE NORMAL WEIGHT NW CONDITIONS CONNECTION 0/C ON CENTER CONSTRUCTIONS OPNG OPENING CONTINUOUS OPPOSITE CONTR CONTRACTOR COORD COORDINATI

CORR

DEMO

DEPT

DIM

DIR

DWG

EQUIP

 $\mathsf{E}\!-\!\mathsf{W}$

EXIST

EXTR

FOR

GALV

GRTG

HDR

HORIZ

CORRUGATED

CUBIC YARD

DEMOLITION

DEPARTMEN1

DETAIL

DIAMETER

DIMENSION

DIRECTION

DRAWING

EACH FACE

ELEVATION

ELECTRIC

ELEVATOR

EMBEDMENT

ENCLOSURE

EQUIPMENT

ETCETERA

FACH WAY

EAST WEST

EXISTING

FOOTING

EXPANSION

EXPANSION JOINT

HEAT, VENTILATION

INSIDE DIAMETER

INTERIOR FACE

INCLUDING

INFORMATION

INSULATION

& AIR CONDITIONING

EDGE OF SLAB

EMBEDDED PLATE

ENGINEER OF RECORI

DOWN

EACH

DOWEL

POUNDS PER CUBIC FEET PLATE POUNDS PER LINEAR FOOT PSF POUNDS PER SQUARE FOOT POUNDS PER SQUARE INCH POST TENSION REINFORCED CONCRETE

ROOF DRAIN REFERENCE REINFORCEMENT REQUIRED REQUEST FOR INFORMATION SOUTH SPANDREL BEAM

SECTION SQUARE FOOT SHEET SLAB SPACING SPA SPEC **SPECIFICATIONS** SOUARF STANDARD STIFF STIFFENER STEEL **STRUCT STRUCTURAL** EACH WAY SHEARWALL SHORT WAY S.W. SIMILAR

CENTERLINE

PLATE

ANGLE

DIAMETER

SCHEDULE

EXTENSION EXTERIOR TOP AND BOTTOM THICK TOP OF FOUNDATION TO BE DETERMINED FACE OF BUILDING TEMP TEMPORARY FIRE PROOFING TONS PER SQUARE FOOT TYPICAL UON UNLESS OTHERWISE NOTED UPTURNED BEAM GALVANIZED

REINF

REQ'D

SCHED

VERT GENERAL CONTRACTOR VERIFY IN FIELD GRADE BEAM GRATING GYPSUM BOARD WITH WITH OUT HEADER WIDE FLANGE HEIGHT WORKING POINT HORIZONTAI WATER PROOFING HIGH POINT WATER STOP HOUR WIND TRUSS HIGH STRENGTH WELDED WIRE FABRIC

GENERAL NOTES:

1. ALL WORK TO BE PERFORMED IN COMPLIANCE WITH THE NEW YORK CITY BUILDING CODE, LATEST EDITION AND ALL SUPPLEMENTS. 2. CONTRACTOR SHALL VERIFY ALL CONDITIONS AND DIMENSIONS IN THE FIELD AND BE RESPONSIBLE FOR ACCURATE COORDINATION WHERE POSSIBLE. EXISTING FRAMING DIMENSIONS WAS TAKEN FROM EXISTING DWGS. AND SHALL BE VERIFIED ON SITE. DISCREPANCIES SHALL BE REPORTED TO ARCH. AND ENGINEER BEFORE PROCEEDING.

3. TEMPORARY SHORING IS REQUIRED AT ALL LOCATIONS WHERE PARTIAL REMOVAL OF BEAMS IS REQUIRED. CONTRACTOR IS RESPONSIBLE FOR ENGINEERING AND CONTROLLED INSPECTION OF TEMPORARY SYSTEMS. 4. THE CONTRACTOR SHALL USE THESE DRAWINGS IN CONJUNCTION WITH THE

ARCHITECTURAL AND MECHANICAL DEMOLITION DRAWINGS. IN THE EVENT OF CONFLICTS, THE CONTRACTOR SHALL NOTIFY THE ARCHITECT AND THE ENGINEER. 5. ALL UNDERPINNING, SHEETING, SHORING OR OTHER CONSTRUCTION REQUIRED FOR THE SUPPORT OF ADJACENT PROPERTIES, BUILDINGS, SIDEWALKS, UTILITIES, ETC., SHALL BE SUBJECT TO SPECIAL INSPECTION AS REQUIRED BY THE CODE. THE CONTRACTOR SHALL RETAIN A LICENSED PROFESSIONAL ENGINEER ACCEPTABLE TO THE ENGINEER OF RECORD TO PROVIDE THE NECESSARY DESIGN. THE CONTRACTOR'S PROFESSIONAL ENGINEER SHALL (PREPARE AND FILE THE REQUIRED FORMS FOR THE WORK WITH THE BUILDING

FOUNDATION NOTES

<u>A. EXCAVATION</u>

DEPARTMENT.

1. ALL SPREAD FOOTINGS AND FOUNDATION WALLS SHALL BEAR ON 40 TSF ROCK NYCBC CLASS 16 OR BETTER, U.O.N ON PLAN

2. WHERE THE REQUIRED BEARING MATERIAL IS NOT FOUND AT THE ANTICIPATED ELEVATION SHOWN (ELEVATION BASED ON BORING INTERPOLATED DATA) THE FOOTINGS SHALL BE LOWERED TO A DEPTH AT WHICH THE

REQUIRED BEARING CAPACITY IS FOUND. 3. WHERE EXISTING FOOTING OR FOUNDATIONS OF ADJACENT PROPERTY IS LOWER THAN ELEVATIONS SHOWN, NEW FOUNDATIONS ARE TO BE LOWERED TO SAME ELEVATION. WHERE NEW FOUNDATION IS LOWER THAN EXISTING FOUNDATIONS CONTRACTOR IS TO UNDERPIN EXISTING FOUNDATION. CONTRACTOR IS TO ESTABLISH EXISTING

CONDITIONS BEFORE COMMENCING WORK AND NOTIFY THE ENGINEER. 4. ALL UNDERPINNING, SHEETING, SHORING OR OTHER CONSTRUCTION REQUIRED FOR THE SUPPORT OF ADJACENT PROPERTIES, BUILDINGS, SIDEWALKS, UTILITIES, ETC., SHALL BE SUBJECT TO SPECIAL INSPECTION AS REQUIRED BY THE CODE. THE CONTRACTOR SHALL RETAIN A LICENSED PROFESSIONAL ENGINEER ACCEPTABLE TO THE ENGINEER OF RECORD TO PROVIDE THE NECESSARY DESIGN. THE CONTRACTOR'S PROFESSIONAL ENGINEER SHALL PREPARE AND FILE THE REQUIRED FORMS FOR THE WORK WITH THE BUILDING DEPARTMENT.

B. CONCRETE AND STEEL REINFORCEMEN

1. NO CONCRETE FOOTING OR FOUNDATION WALL SHALL BE POURED UNTIL SUBGRADE FOR SAME HAS BEEN

APPROVED BY A LICENSED PROFESSIONAL ENGINEER. 2. ALL CONCRETE SHALL BE NORMAL WEIGHT CONTROLLED CONCRETE, U.O.N., AND COMPLY WITH A.C.I. BUILDING

CODE AND THE CURRENT NEW YORK CITY BUILDING CODE. 3. CONCRETE STRENGTH SHALL BE AS FOLLOWS, UNLESS OTHERWISE NOTED: 8000 PSI. -FOUNDATION FOR COLUMNS/WALLS 7000 PSI.

-BUTTRESSES, FOUNDATION WALLS -FOOTING SEALERS/ MUD SLAB 3000 PSI. 4000 PSI. -SLAB ON GROUND*

*IF SLAB ON GROUND IS POURED BEFORE THE COLUMNS ABOVE AND THE COLUMN STRENGTH IS 5000 PSI OR GREATER, THE SLAB ON GROUND STRENGTH IS TO BE ACCORDING TO THE "DETAIL OF BEAM AND SLAB CONCRETE PLACEMENT AT HIGH STRENGTH COLUMN." IN ADDITION THE DOWELS EXTENDING ABOVE THE FOOTINGS, PIERS OR PILE CAPS ARE TO BE LENGTHENED A MIN. 12", BEYOND THAT SHOWN OR CALLED FOR IN DETAILS.

4. ALL STEEL REINFORCEMENT SHALL HAVE AN ULTIMATE TENSILE STRENGTH OF 90,000 PSI AS PER A.S.T.M. A615-83 GRADE 60. THE CONTRACTOR SHALL FURNISH AND INSTALL ALL THE NECESSARY CHAIRS, REBARS, TIES, SPACERS. F.T... TO SECURE AND SUPPORT THE REINFORCING WHILE PLACING THE CONCRETE. ALL #14 AND LARGER DIAMETER REBAR MUST TO BE GRADE 97 REINFORCEMENT.

NOTES FOR GRADE 97 REINFORCEMENT (#14, #18, #20, & #24 BARS): a. ALL 97 ksi REINFORCING SHALL MEET THE NYC BUILDING DEPARTMENT BULLETION 2010-003 FOR MATERIAL AND SPECIAL INSPECTION REQUIREMENTS.

b. THE YIELD STRENGTH OF 97 ksi REBAR SHALL BE TAKEN AS THE STRESS CORRESPONDING TO A STRAIN OF 0.35% AS EVALUATED BY ASTM A370.

c. MINIMUM REINFORCEMENT ELONGATION SHALL NOT BE LESS THAN 6% PER ASTM A370.

d. MECHANICAL COUPLERS SHALL BE PROVIDED THAT CONFORM TO SECTION 3.5 OF AC 237 AND CH. 12 OF ACI 318. ADDITIONALLY MECHANICAL COUPLERS SHALL COMPLY WITH AC 133. SPLICES

SHALL BE STAGGERED SUCH THAT NO MORE THAN HALF OF THE TOTAL REINFORCEMENTIS SPLICED WITHIN 36 INCHES. ALTERNATE COUPLERS LOCATION AT EVERY OTHER BAR PER REQUIREMENTS OF THIS NOTE IN SHEARWALLS AND CONCRETE COLUMNS.

5. ALL BARS MARKED CONTINUOUS, SHALL BE LAPPED ACCORDING TO TABLES ON FO-203 AT SPLICES AND CORNERS EXCEPT AS OTHERWISE SHOWN ON PLANS. LAP CONTINUOUS TOP BARS AT CENTER BETWEEN SUPPORTS AND BOTTOM BARS AT SUPPORTS. HOOK TOP BARS AT DISCONTINUOUS ENDS.

6. VERTICAL CONSTRUCTION JOINTS IN ALL WALLS SHALL BE USED ONLY IF UNAVOIDABLE, OR UNLESS OTHERWISE NOTED, AND TO BE LOCATED AT LEAST 4'-0" FROM ANY SUPPORTING COLUMN OR WALL OPENING. DISTANCE BETWEEN JOINTS IN WALL SHALL BE ALLOWED AS PER SPECIFICATIONS. NO HORIZONTAL CONSTRUCTION JOINTS WILL BE ALLOWED IN STRAP BEAMS.

7. IN NO CASE SHALL TRUCKS, BULLDOZERS, OR OTHER HEAVY EQUIPMENT BE PERMITTED CLOSER THAN 8'-0" FROM

ANY FOUNDATION WALL UNLESS THE WALL IS BRACED BY THE CONTRACTOR. 8. TEMPORARY BRACING SHALL BE PROVIDED FOR ALL BUTTRESSES. WHERE BUTTRESSES DO NOT EXIST OR SPACING BETWEEN BUTTRESSES EXCEED 25 FEET, AND WHERE THE DIFFERENCE IN LEVEL BETWEEN INSIDE AND OUTSIDE GRADE IS MORE THAN 4'-0", INTERMEDIATE BRACING SHALL BE PROVIDED. WHERE RAMPS OCCUR, THE GRADE ELEVATION OUTSIDE OF RAMP WALLS SHALL BE USED IN FIGURING THE DIFFERENCE IN LEVEL. CORNER BUTTRESSES NEED NOT BE BRACED. NO BACKFILLING IS TO BE DONE BEFORE ALL SLABS BRACING WALLS ARE IN PLACE UNLESS APPROVED BY THE ENGINEER

9. CONTRACTOR TO INSTALL ALL PIPE SLEEVES, BOXED OPENINGS, ANCHOR BOLTS, ETC., AS REQUIRED FOR THE VARIOUS TRADES. WALL POCKETS TO RECEIVE BEAMS AND SLABS SHALL BE PROVIDED AS REQUIRED FOR THE SUPERSTRUCTURE. SHOP DRAWINGS SHOWING THE POSITION OF OPENINGS SHALL BE SUBMITTED TO THE STRUCTURAL ENGINEER PRIOR TO PLACING CONCRETE.

10. MINIMUM COVER FOR REINFORCING STEEL SHALL BE 3/4" FOR INTERIOR SLABS AND INTERIOR WALL SURFACES; 1½" FOR BEAMS, GIRDERS, AND COLUMNS (TIES, STIRRUPS OR PRIMARY REINFORCEMENT). FOR ALL CONCRETE EXPOSED TO WEATHER AND EARTH FILL, COVER SHALL BE 2" (1½" FOR STIRRUPS). FOR CONCRETE PLACED

AGAINST EARTH, MINIMUM COVER SHALL BE 3". 11. FOR PIER SIZES SEE STRUCTURAL DRAWINGS. WHERE PIER IS REQUIRED BUT NOT SHOWN ON PLANS THE SIZE

OF THE PIER SHOULD BE AS SHOWN IN TYP. DETAIL ON FO-201 12. WHERE A PIER IS INDICATED ON THE FOUNDATION PLAN BUT ELIMINATED IN THE FIELD (GOOD MATERIAL HIGHER THAN ASSUMED) THE ENGINEER SHALL BE NOTIFIED AS DEPTH OF FOOTING MAY NEED TO BE INCREASED. 13. THE CONTRACTOR MUST SUBMIT REINFORCING SHOP DRAWINGS TO THE STRUCTURAL ENGINEER FOR REVIEW. NO

CONSTRUCTION IS TO BE STARTED UNTIL THE SHOP DRAWINGS ARE REVIEWED BY THE ENGINEER. 14. THE STRUCTURAL ENGINEER OR HIS FIELD QUALIFIED REPRESENTATIVE MUST CHECK AND APPROVE ALL STEEL REINFORCING PRIOR TO CONCRETE PLACEMENT.

C. CODES AND TESTS

CITY BUILDING CODE AS AMENDED AND A.C.I. 318.

1. THIS STRUCTURE HAS BEEN DESIGNED UNDER THE PROVISIONS OF THE NEW YORK

2. ALL CONTROLLED CONCRETE SHALL COMPLY WITH THE A.C.I. 318 BUILDING CODE. APPLICATION FOR CONTROLLED CONCRETE WITH CONCRETE TESTS AND CURVES OF TESTS FOR THE PRELIMINARY DESIGN MIX PREPARED BY AN APPROVED LABORATORY MUST BE SUBMITTED TO THE ENGINEER FOR FILING WITH THE BUILDING DEPARTMENT. NO CONCRETE SHALL BE PLACED WITHOUT THE DESIGN MIX BEING APPROVED BY THE BUILDING DEPARTMENT.

3. DESIGN AND CONSTRUCTION OF FORMWORK IS TO COMPLY WITH THE A.C.I. 318

4. THE DESIGN DETAILS AND NOTES INCLUDED HEREIN ARE IN COMPLIANCE WITH

BUILDING CODE AND NEW YORK CITY BUILDING CODE AS AMENDED. LOCAL LAW 17/95.

SUPERSTRUCTURE CONCRETE NOTES

A. CONCRETE

1. ALL CONCRETE SHALL BE NORMAL WEIGHT CONTROLLED CONCRETE, U.O.N., AND COMPLY WITH THE A.C.I. BUILDING CODE AND THE CURRENT NEW YORK CITY

BUILDING CODE 2. CONCRETE STRENGTH SHALL BE AS FOLLOWS, UNLESS OTHERWISE NOTED: SLABS AND BEAMS U.O.N. ON PLANS 8600 PSI FROM 1ST TO 19TH FL SLABS AND BEAMS U.O.N. ON PLANS 7200 PSI FROM 20™ TO UP SHEAR WALLS & COLUMNS SEE COLUMN SCHEDULE LINK BEAMS SAME AS SHEARWALL STRUCTURE

S. NO CONCRETE SHALL BE PLACED UNTIL THE CONTRACTOR HAS INSTALLED ALL THE INSERTS AND DOVETAILS NECESSARY TO PROVIDE SUPPORT FOR MULLIONS, APPLIED FINISHES, PARTITIONS, PIPES, DUCTS, EQUIPMENT, ETC., AS REQUIRED IN ARCHITECTURAL, H.V.A.C. AND STRUCTURAL DRAWINGS. WHERE BRICK VENEER EXCEEDS 18" IN HEIGHT, PROVIDE DOVETAIL TYPE MASONRY ANCHORS SPACED AT 24" O/C IN ALL BACK UP VERTICAL CONCRETE SURFACES.

4. CONTRACTOR SHALL VERIFY LOCATIONS AND DIMENSIONS OF ALL SLOTS PIPEDE SLEEVES, DUCTS AND ANY OTHER CONCRETE PENETRATIONS AS REQUIRED FOR VARIOUS TRADES BEFORE CONCRETE IS PLACED.

SHOP DRAWINGS SHOWING COMPOSITE LAYOUT OF ALL PENETRATIONS MUST BE SUBMITTED TO THE ENGINEER FOR APPROVAL PRIOR TO CONSTRUCTION.

5. ALL PLUMBING AND ELECTRICAL SLOTS SHALL BE FILLED WITH CONCRETE TO THE SAME DEPTH AS FLOOR AFTER CONDUITS AND/OR PIPES ARE INSTALLED

6. NO PIPES OR CONDUITS EXCEEDING 1/3 SLAB THICKNESS IN OUTSIDE DIAMETER NOR OVER NOMINAL 2" INSIDE DIAMETER SHALL BE EMBEDDED SHOULD BE PLACED CLOSER THAN 3 DIAMETER ON CENTER NOR PASS WITHIN 24" OF COLUMN FACE, U.O.N. JUNCTION BOXES MAY BE PLACED IN STRUCTURAL CONCRETE SLAB BUT SHALL NOT EXCEED 4½"x4½"x3½" IN DEPTH AND SHALL BE

SEPARATED FROM OTHER JUNCTION BOXES BY NOT LESS THAN 8" OF CONCRETE. 7. ALL MEMBERS IN THE FLOOR SYSTEM INCLUDING BEAMS, BRACKETS, COLUMN CAPITALS AND HAUNCHES SHALL BE PLACED MONOLITHICALLY. VERTICAL CONSTRUCTION JOINTS NECESSARY MAY BE MADE AT CENTER OF BEAM OR SLAB USING APPROVED BULKHEADS AND ADDITIONAL REINFORCING AS SHOWN ON

DETAILS. 8. NO CONCRETE FLOOR SYSTEM IS TO BE INSTALLED UNTIL AT LEAST TWO HOURS HAVE PASSED AFTER THE SUPPORTING COLUMNS AND WALLS ARE PLACED. 9. WHEN PLACING CONCRETE AGAINST AN ADJACENT BUILDING OR AT EXPANSION JOINT, AT LEAST 1" (U.O.N.) OF HIGH DENSITY STYROFOAM SHALL BE PLACED AT THE INTERFACE BETWEEN THE EXISTING AND NEW CONCRETE. IN ADDITION, THE CONTRACTOR MUST TAKE ALL THE NECESSARY MEASURES SO AS NOT TO CREATE

CONCRETE. 10. TEMPORARY SHORING AND RESHORING SHALL REMAIN IN PLACE AT LEAST 28 DAYS AFTER PLACEMENT OF CONCRETE

ANY DAMAGE TO THE EXISTING CONSTRUCTION WHILE PLACING THE NEW

11. NO DEVIATION FROM THE STRUCTURAL PLANS SHALL BE PERMITTED WITHOUT THE EXPRESS WRITTEN CONSENT OF THE STRUCTURAL ENGINEER.

B. REINFORCEMENT

1. ALL STEEL REINFORCEMENT (STIRRUPS AND TIES INCLUSIVE) SHALL HAVE AN ULTIMATE TENSILE STRENGTH OF 90,000 PSI AS PER A.S.T.M. A615 GRADE 60. THE CONTRACTOR SHALL FURNISH AND INSTALL ALL THE CHAIRS, REBARS, TIES, SPACERS, ETC., TO SECURE AND SUPPORT THE REINFORCING WHILE PLACING THE CONCRETE.

2. ALL #14 AND LARGER DIAMETER REBAR MUST TO BE GRADE 97 REINFORCEMENT. NOTES FOR GRADE 97 REINFORCEMENT (#14, #18, #20, & #24 BARS) a. ALL 97 ksi REINFORCING SHALL MEET THE NYC BUILDING

DEPARTMENT BULLETION 2010-003 FOR MATERIAL AND SPECIAL INSPECTION REQUIREMENTS. b. THE YIELD STRENGTH OF 97 ksi REBAR SHALL BE TAKEN AS THE

STRESS CORRESPONDING TO A STRAIN OF 0.35% AS EVALUATED

BY ASTM A370. c. MINIMUM REINFORCEMENT ELONGATION SHALL NOT BE LESS THAN 6% PER ASTM A370.

d. MECHANICAL COUPLERS SHALL BE PROVIDED THAT CONFORM TO SECTION 3.5 OF AC 237 AND CH. 12 OF ACI 318. ADDITIONALLY MECHANICAL COUPLERS SHALL COMPLY WITH AC 133. SPLICES SHALL BE STAGGERED SUCH THAT NO MORE THAN HALF OF THE TOTAL REINFORCEMENTIS SPLICED WITHIN 36 INCHES. ALTERNATE COUPLERS LOCATION AT EVERY OTHER BAR PER REQUIREMENTS OF THIS NOTE IN SHEARWALLS AND CONCRETE COLUMNS.

3. THE CONTRACTOR MUST SUBMIT REINFORCING SHOP DRAWINGS TO THE STRUCTURAL ENGINEER FOR REVIEW. NO CONSTRUCTION IS TO BE STARTED UNTIL THE SHOP DRAWINGS ARE REVIEWED BY THE ENGINEER.

4. THE STRUCTURAL ENGINEER OR HIS FIELD QUALIFIED REPRESENTATIVE MUST CHECK AND APPROVE ALL STEEL REINFORCEMENT PRIOR TO CONCRETE

5. ALL REINFORCING BARS MARKED CONTINUOUS SHALL BE LAPPED AT SPLICES AND CORNERS IN CONFORMANCE WITH LAP SPLICE TABLES IN TYPICAL DETAILS UNLESS OTHERWISE NOTED. LAP CONTINUOUS TOP BARS AT CENTER BETWEEN SUPPORTS AS REQUIRED. TERMIN-ATE CONTINUOUS BARS AT END SUPPORTS WITH STANDARD HOOKS, U.O.N.

6. MINIMUM COVER FOR REINFORCING STEEL SHALL BE 4" FOR INTERIOR SLABS AND INTERIOR WALL SURFACES; 1½" FOR BEAMS, GIRDERS AND COLUMNS (TIES, STIRRUPS OR PRIMARY REINFORCEMENT). FOR ALL CONCRETE EXPOSED TO WEATHER AND EARTH FILL, COVER SHALL BE 2 (1½" FOR STIRRUPS). FOR CONCRETE PLACED AGAINST EARTH, MINIMUM COVER SHALL BE 3".

<u>C. CODES AND TESTS</u>

1. THIS STRUCTURE HAS BEEN DESIGNED UNDER THE PROVISIONS OF THE NEW YORK CITY BUILDING CODE AS AMENDED AND A.C.I. 318. 2. ALL CONTROLLED CONCRETE SHALL COMPLY WITH THE A.C.I. 318 BUILDING CODE

AND THE NEW YORK CITY BUILDING CODE. A SPECIAL AMENDMENT FORM FOR CONTROLLED CONCRETE WITH CONCRETE TESTS AND CURVES OF TESTS FOR THE PRELIMINARY DESIGN MIX PREPARED BY AN APPROVED LABORATORY MUST BE SUBMITTED TO THE ENGINEER FOR FILING WITH THE BUILDING DEPARTMENT. NO CONCRETE IS TO BE PLACED BEFORE SUCH AN AMENDMENT IS APPROVED BY

THE BUILDING DEPARTMENT. 3. DESIGN AND CONSTRUCTION OF FORMWORK IS TO COMPLY WITH THE A.C.I. 318 BUILDING CODE AND THE NEW YORK CITY BUILDING CODE AS AMENDED. 4. TRANSPORTING, PLACING, CURING AND DEPOSITING OF CONCRETE SHALL

COMPLY WITH THE A.C.I. BUILDING CODE. 5. ALL REINFORCING BARS SHALL BE DEFORMED BARS CONFORMING TO "SPECIFICATIONS FOR DEFORMED BILLET-STEEL BARS FOR CONCRETE REINFORCEMENT" A.S.T.M. A615 GRADE 60. THE STEEL SUPPLIER SHALL PROVIDE THE ENGINEER WITH AN AFFIDAVIT OF THE PRODUCER OF STEEL

CERTIFYING THAT THE STEEL MEETS THE REQUIREMENTS OF THE A.S.T.M. 6. ALL STRUCTURAL STEEL (LINTELS, DUNNAGE BEAMS, ETC.) SHALL CONFORM TO A.S.T.M. A-36, U.O.N.

D. SEISMIC AND WIND CRITERIA

1. THE STRUCTURE HAS BEEN DESIGNED IN ACCORDANCE WITH THE LATEST NEW YORK CITY BUILDING CODE (NYCBC 2014).

2. <u>WIND DESIGN DATA:</u> PER WIND TUNNEL LAB REPORT BY BLWT DATED NOVEMBER 24, 2015

3. <u>EARTHQUAKE DESIGN DATA:</u> AS PER GEOTECHNICAL REPORT BY LANGAN DATED MARCH 6, 2015 - SEISMIC IMPORTANCE FACTOR = 1

 $-S_c = 0.281, S_1 = 0.073$ - SITE CLASS B - SEISMIC DESIGN CATEGORY

- DEFLECTION AMPLIFICATION FACTOR C $_{\mathsf{D}}$

= B - SEISMIC FORCE RESISTING SYSTEM = ORDINARY REINFORCED CONCRETE SHEARWALLS RESPONSE MODIFICATION FACTORS: R = 5= EQUIVALENT STATIC METHOD ANALYSIS PROCEDURE USED

= 4.5

- DESIGN BASE SHEAR (V) : E/W = 875 kips N/S = 875 kips - SEISMIC RESPONSE COEFFICIENT (C) : E/W = 0.0082N/S = 0.0082

4. STRUCTURAL SEPARATIONS (NYCBC-1613.7.): ALL STRUCTURES SHALL BE SEPARATED FROM ADJACENT STRUCTURES. WHEN A STRUCTURE ADJOINS A PROPERTY LINE NOT COMMON TO A PUBLIC WAY (TYPICALLY SIDE OR REAR LOT LINES), THAT STRUCTURE SHALL ALSO BE SET BACK FROM THE PROPERTY LINE BY AT LEAST 1 INCH FOR EACH 50 FEET OF HEIGHT AND

A MINIMUM OF 1 INCH FOR STRUCTURE WITH HEIGHTS LESS THAT 50 FEET.

NON-STRUCTURAL ITEMS SHOWN ON THE STRUCTURAL/FOUNDATION DRAWINGS

1. THE FOLLOWING NON-STRUCTURAL ITEMS MAY BE SHOWN ON THE STRUCTURAL AND/OR FOUNDATION DRAWINGS FOR THE PURPOSE OF CLARITY IN INTERFACE WITH STRUCTURAL AND/OR FOUNDATION WORK. ITEMS BELOW MAY NOT BE FULLY DEFINED ON THE STRUCTURAL/FOUNDATION DRAWINGS. THE INFORMATION FOR NON-STRUCTURAL ELEMENTS IS FURNISHED BY OTHER CONSULTANTS AS LISTED BELOW. ALL RFI AND SHOP DRAWINGS RELATED TO THESE NON-STRUCTURAL ITEMS SHALL BE SUBMITTED TO THE CONSULTANTS LISTED BELOW FOR THEIR REVIEW AND APPROVAL.

<u>SEOTECHNICAL ENGINEER:</u>

- FOUNDATION/UNDERSLAB WATERPROOFING, DAMPPROOFING SYSTEMS - WALL AND UNDERSLAB DRAINAGE SYSTEM, INCLUDING SUMP PITS, GRAVEL & PIPING, CLEANOUTS ROCK ANCHORS

ARCHITECT OF RECORD

- WATERPROOFING/DAMPPROOFING APPLIED TO EXPOSED SURFACES, ELEVATOR OR SUMP PIT INTERIOR SURFACES

PAINT

FIREPROOFING - CONCRETE CURBS: HEIGHT, WIDTH, EXTENT, LOCATION - BRICK, BLOCK, TILE MASONRY, METAL PANELS, PRECAST FACADE

PANELS, CURTAIN WALLS AND ALL OTHER FACADE SYSTEMS - ROOFING SYSTEMS, DRAIN LOCATIONS, SLOPES TO DRAINS

FILLS, INSULATION, PAVERS OR GRAVEL - FLOATING/SECONDARY SLABS

CONTROLLED INSPECTIONS (TERMINOLOGY PER CURRENT | CODE | REFERENCES CURRENT TR-1) CDECIAL INCDECTION

SPECIAL INSPECTION	REFERENCES		
CONCRETE - CAST IN PLACE	1704.4		
CONCRETE TEST CYLINDERS* (TR2)	1905.6		
CONCRETE DESIGN MIX* (TR3)	1905.3		
MASONRY	1704.5		
SOILS - SITE PREPARATION	1704.7.1		
SOILS - FILL PLACEMENT & IN-PLACE DENSITY	1704.7.2 1704.7.3		
SOILS - INVESTIGATIONS (BORINGS/TEST PITS) (TR4)	1704.7.4		
UNDERPINNING	1704.20.3		
WALL PANELS, CURTAIN WALLS AND VENEERS (ATTACHMENT TO BUILDING)	1704.10		
SPRAYED FIRE RESISTANT MATERIALS	1704.11		
STRUCTURAL SAFETY — STRUCTURAL STABILITY	1704.20		
EXCAVATION — SHEETING, SHORING AND BRACING	1704.20 & 3304.4.1		
FIRESTOP, DRAFTSTOP AND FIREBLOCK SYSTEMS	1704.27		
PROGRESS INSPECTION			
FOOTING AND FOUNDATION	109.3.1		
FINAL	28-116.2.4.2 & 109.5 AND DIRECTIVE 14-(1975)		

* THESE TEST MUST BE PERFORMED BY A LICENSED CONCRETE TESTING LAB

MECHANICAL ROOMS

PRIVATE TERRACE

LOBBIES/PUBLIC

TERRACE/RETAIL

1. REFER TO THE PROJECT SPECIFICATIONS FOR ADDITIONAL INFORMATION ON SCOPE AND DETAILED REQUIREMENTS FOR INSPECTIONS.

2. ALL SPECIAL INSPECTIONS SHALL BE PERFORMED UNDER THE SUPERVISION OF A PROFESSIONAL ENGINEER LICENSED IN THE STATE OF NEW YORK. 3. REPORTS OF RESULTS SHALL BE SUBMITTED TO THE OWNER AND

INSPECTION REPORTS SHALL BE FILED WITH THE BUILDING DEPARTMENT (THROUGH THE APPLICANT) 4. REPORTS SHALL STATE WHETHER RESULTS COMPLY WITH CONTRACT REQUIREMENTS, SUMMARIZE THE TYPE OF TEST, THE LOCATION OR COMPONENT TESTED, AND RECOMMEND ANY REMEDIAL MEASURES

ARCHITECT FOR REVIEW. SIGNED COPIES OF ALL TESTS AND

REQUIRED. REPORT SHOULD NOTE ANY OTHER DEVIATIONS FROM THE CONTRACT DOCUMENTS. 5. FOR ITEMS OF WORK OF OTHER TRADES WHICH ARE SUBJECT TO SPECIAL INSPECTION, SEE THE CITY OF NEW YORK BUILDING CODE,

AS WELL AS ARCHITECTURAL, MECHANICAL, ELECTRICAL, PLUMBING, FTC. DRAWINGS AND SPECIFICATIONS. 6. IN ADDITION TO THE ABOVE REQUIREMENTS, ALL COLUMN SPLICE, BEAM MOMENT CONNECTIONS AT BEAMS DESIGNATED AS "LLRS" AND BRACE FRAME OR WIND TRUSS CONNECTIONS (PER S-940 SERIES OF DWGS.) SHALL COMPLY WITH THE INSPECTION REQUIREMENTS OF AWS D1.8 "STRUCTURAL WELDING CODE-SEISMIC SUPPLEMENT", IF WELDING IS PRESENT IN CONNECTION.

PARTITION/FILL CEIL. & MECH. OCCUPANCY LIVE LOAD &/OR FINISHES (PSF) 100 CORRIDORS 100 RESIDENTIAL 40

75

60

100

LOADING SCHEDULE

LEGEND:

INDICATES ADDITIONAL WIND BARS INDICATES THE BOTTOM OF FOUNDATION WALL ELEVATION INDICATES THE TOP OF FOUNDATION WALL ELEVATION INDICATES BOTTOM OF PILE CAP ELEVATION

5 Fxxxx INDICATES FOOTING MARK $(XX \times XX)$ INDICATES SIZE OF PIER IN INCHES, FIRST DIMENSION SHOWN IS IN THE EAST-WEST DIRECTION. INDICATES ROCK ANCHOR. INDICATES UNDERSLAB DRAINAGE PIPE

INDICATES CLEANOUT

INDICATES ADDITIONAL TOP REINFORCEMENT AT SUPPORTS — — INDICATES ADD'L BOTTOM REINFORCING AT SUPPORTS INDICATES ADDITIONAL TOP REINFORCEMENT CONTINUOUS BETWEEN SUPPORTS

INDICATES ADDITIONAL BOTTOM REINFORCEMENT CONTINUOUS 4-7 BETWEEN SUPPORTS 14. — — INDICATES WALKING COLUMN MID-DEPTH SLAB REINFORCEMENT

INDICATES D6 LENTON TERMINATOR INDICATES MOMENT CONNECTION

INDICATES CAMBERS ———— INDICATES STRUCTURAL STEEL BEAMS

-1ST & 4TH LAYERS

INDICATES ORDER OF BAR PLACEMENT AS SHOWN ON PLAN.

-2™ & 3™ LAYERS INDICATES CHANGE IN ELEVATION

INDICATES CONCRETE COLUMN/SHEARWALL/FOUNDATION WALL INDICATES CONCRETE COLUMN/SHEARWALL BELOW

INDICATES SLAB OPENING (FIRST DIMENSION IS IN EAST-WEST

INDICATES CONCRETE WALL

INDICATES COLUMN ABOVE OR BELOW

INDICATES POST DESIGNATION INDICATES SHEARWALL DESIGNATION

~~~~~~~\

POST SCHEDULE

INDICATES HSS 10x8x1/2 STEEL TUBE POST.

INDICATES HSS 10x10x% STEEL TUBE POST.

INDICATES 12x14 CONC. POST REINF. W/4-#7 VERT. & #3 TIES @12" O.C. INDICATES 18x18 CONC. POST REINF.

W/4-#7 VERT. & #4 TIES @12" O.C.

Damian Titus

Du TO

APPROVED

Under Directive 2 of 1975

AMENDED APPLICATION

NYC Development Hub

Date: 05/25/2016

Fifth Avenue

NEW YORK, NY

VICTOR NOMAD LLC **CONSTRUCTION MANAGER:** LEND LEASE 200 PARK AVENUE, 9TH FLOOR NEW YORK, NY 10166 TEL: 212 592 6700

ARCHITECT RAFAEL VIÑOLY ARCHITECTS PC **50 VANDAM STREET** NEW YORK, NY 10013 TEL: 212 924 5060 FAX: 212 924 5858

STRUCTURAL ENGINEER: WSP GROUP 228 EAST 45TH STREET, 3RD FLOOR NEW YORK, NY 10017 TEL: 212 687 9888

MEP/FP/IT ENGINEER: MGE ENGINEERING 116 WEST 32ND STREET, 12TH FLOOR NEW YORK, NY 10001 TEL: 212 643 9055

GEOTECH CIVIL ENGINEER: LANGAN ENGINEERING 300 KIMBALL DRIVE, 4TH FLOOR PARSIPPANY, NJ, 07054 TEL: 973 560 4900

VERTICAL TRANSPORT. CONSULTANT: VAN DEUSEN & ASSOCIATES 120 EAGLE ROCK AVENUE, SUITE 310 EAST HANOVER, NJ, 07936 TEL: 973 994 9220

ENCLOSURE CONSULTANT: VIDARIS, INC. 360 PARK AVENUE SOUTH, 15TH FLOOR NEW YORK, NY, 10010

FACADE MAINTENANCE CONSULTANT: ENTEK ENGINEERING LLC 166 AMES STREET HACKENSACK, NJ, 07601 TEL: 201 820 2801

TEL: 212 689 5389

CERAMI & ASSOCIATES 404 FIFTH AVENUE NEW YORK, NY, 10018 TEL: 212 616 4179

ACOUSTICAL CONSULTANT:

LIGHTING CONSULTANT: ONE LUX STUDIO 158 WEST 29TH STREET, 10TH FLOOR **NEW YORK, NY, 10001** TEL: 212 201 5790

SPECIFICATIONS CONSULTANT

589 EIGHTH AVENUE, 17TH FLOOR **NEW YORK, NY, 10018** TEL: 212 691 3248 ENERGY MODELING CONSULTANT:

STEVEN WINTER ASSOCIATES, INC.

ROBERT SCHWARTZ & ASSOCIATES

NEW YORK, NY, 10001 TEL: 212 564 5800 INTERIOR DESIGN CONSULTANT: JEFFREY BEERS INTERNATIONAL 156 5TH AVENUE, PENTHOUSE 2 NEW YORK, NY, 10010

307 SEVENTH AVENUE, SUITE 1701

DESIGN DEVELOPMENT

NYC DEPT. OF BUILDINGS SUBMITTAL

ARCHITECT'S SEAL


TEL: 212 352 2020

04/29/2016 DOB FOUNDATION PAA #1

04/08/2016 DOB SUBMITTAL 04/08/2016 SUPERSTRUCTURE EARLY BID 03/25/2016 DOB FOUNDATION POST APPROVAL AMENDMENT

01/27/2016 FOUNDATION BID ADD. #1 01/18/2016 FOUNDATION BID 12/23/2015 SCHEMATIC DESIGN

04/15/2015 DOB SUBMITTAL 02/28/2015 SCHEMATIC DESIGN ISSUE ISSUE DESCRIPTION NO. DATE

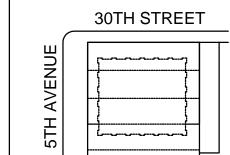

KEY PLAN AND NORTH SIGN IF THIS DRAWING IS NOT 42" X 30" IT IS A REDUCED PRINT: REFER TO GRAPHIC SCALE



GENERAL NOTES, LEGENDS **& ABBREVIATIONS**

SHEET TITLE:



VICTOR NOMAD LLC

CONSTRUCTION MANAGER: LEND LEASE 200 PARK AVENUE, 9TH FLOOR NEW YORK, NY 10166 TEL: 212 592 6700

NEW YORK, NY

ARCHITECT RAFAEL VIÑOLY ARCHITECTS PC **50 VANDAM STREET** NEW YORK, NY 10013 TEL: 212 924 5060 FAX: 212 924 5858

STRUCTURAL ENGINEER: **WSP GROUP** 228 EAST 45TH STREET, 3RD FLOOR NEW YORK, NY 10017

TEL: 212 687 9888 MEP/FP/IT ENGINEER: MGE ENGINEERING 116 WEST 32ND STREET, 12TH FLOOR

NEW YORK, NY 10001 TEL: 212 643 9055 GEOTECH CIVIL ENGINEER: LANGAN ENGINEERING 300 KIMBALL DRIVE, 4TH FLOOR

PARSIPPANY, NJ, 07054

TEL: 973 560 4900

VERTICAL TRANSPORT. CONSULTANT: VAN DEUSEN & ASSOCIATES 120 EAGLE ROCK AVENUE, SUITE 310 EAST HANOVER, NJ, 07936 TEL: 973 994 9220

ENCLOSURE CONSULTANT: VIDARIS, INC. 360 PARK AVENUE SOUTH, 15TH FLOOR NEW YORK, NY, 10010 TEL: 212 689 5389

FACADE MAINTENANCE CONSULTANT: ENTEK ENGINEERING LLC 166 AMES STREET HACKENSACK, NJ, 07601 TEL: 201 820 2801

ACOUSTICAL CONSULTANT: CERAMI & ASSOCIATES 404 FIFTH AVENUE NEW YORK, NY, 10018 TEL: 212 616 4179

LIGHTING CONSULTANT: ONE LUX STUDIO 158 WEST 29TH STREET, 10TH FLOOR **NEW YORK, NY, 10001** TEL: 212 201 5790

SPECIFICATIONS CONSULTANT: ROBERT SCHWARTZ & ASSOCIATES 589 EIGHTH AVENUE, 17TH FLOOR NEW YORK, NY, 10018 TEL: 212 691 3248

ENERGY MODELING CONSULTANT: STEVEN WINTER ASSOCIATES, INC 307 SEVENTH AVENUE, SUITE 1701 NEW YORK, NY, 10001 TEL: 212 564 5800

INTERIOR DESIGN CONSULTANT: JEFFREY BEERS INTERNATIONAL 156 5TH AVENUE, PENTHOUSE 2 NEW YORK, NY, 10010 TEL: 212 352 2020

DESIGN DEVELOPMENT NYC DEPT. OF BUILDINGS SUBMITTAL

ARCHITECT'S SEAL

04/29/2016 DOB FOUNDATION PAA #1 04/08/2016 DOB SUBMITTAL

04/08/2016 SUPERSTRUCTURE EARLY BID 03/25/2016 DOB FOUNDATION POST

APPROVAL AMENDMENT 01/27/2016 FOUNDATION BID ADD. #1

01/18/2016 FOUNDATION BID


12/23/2015 SCHEMATIC DESIGN 04/15/2015 DOB SUBMITTAL

04/01/2015 FOUNDATION BID

02/28/2015 SCHEMATIC DESIGN ISSUE ISSUE DESCRIPTION

NO. DATE

30TH STREET

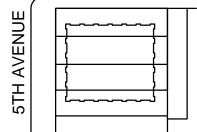



KEY PLAN AND NORTH SIGN IF THIS DRAWING IS NOT 42" X 30" IT IS A REDUCED PRINT; REFER TO GRAPHIC SCALE

1/4'' = 1'-0''

FOUNDATION PLAN



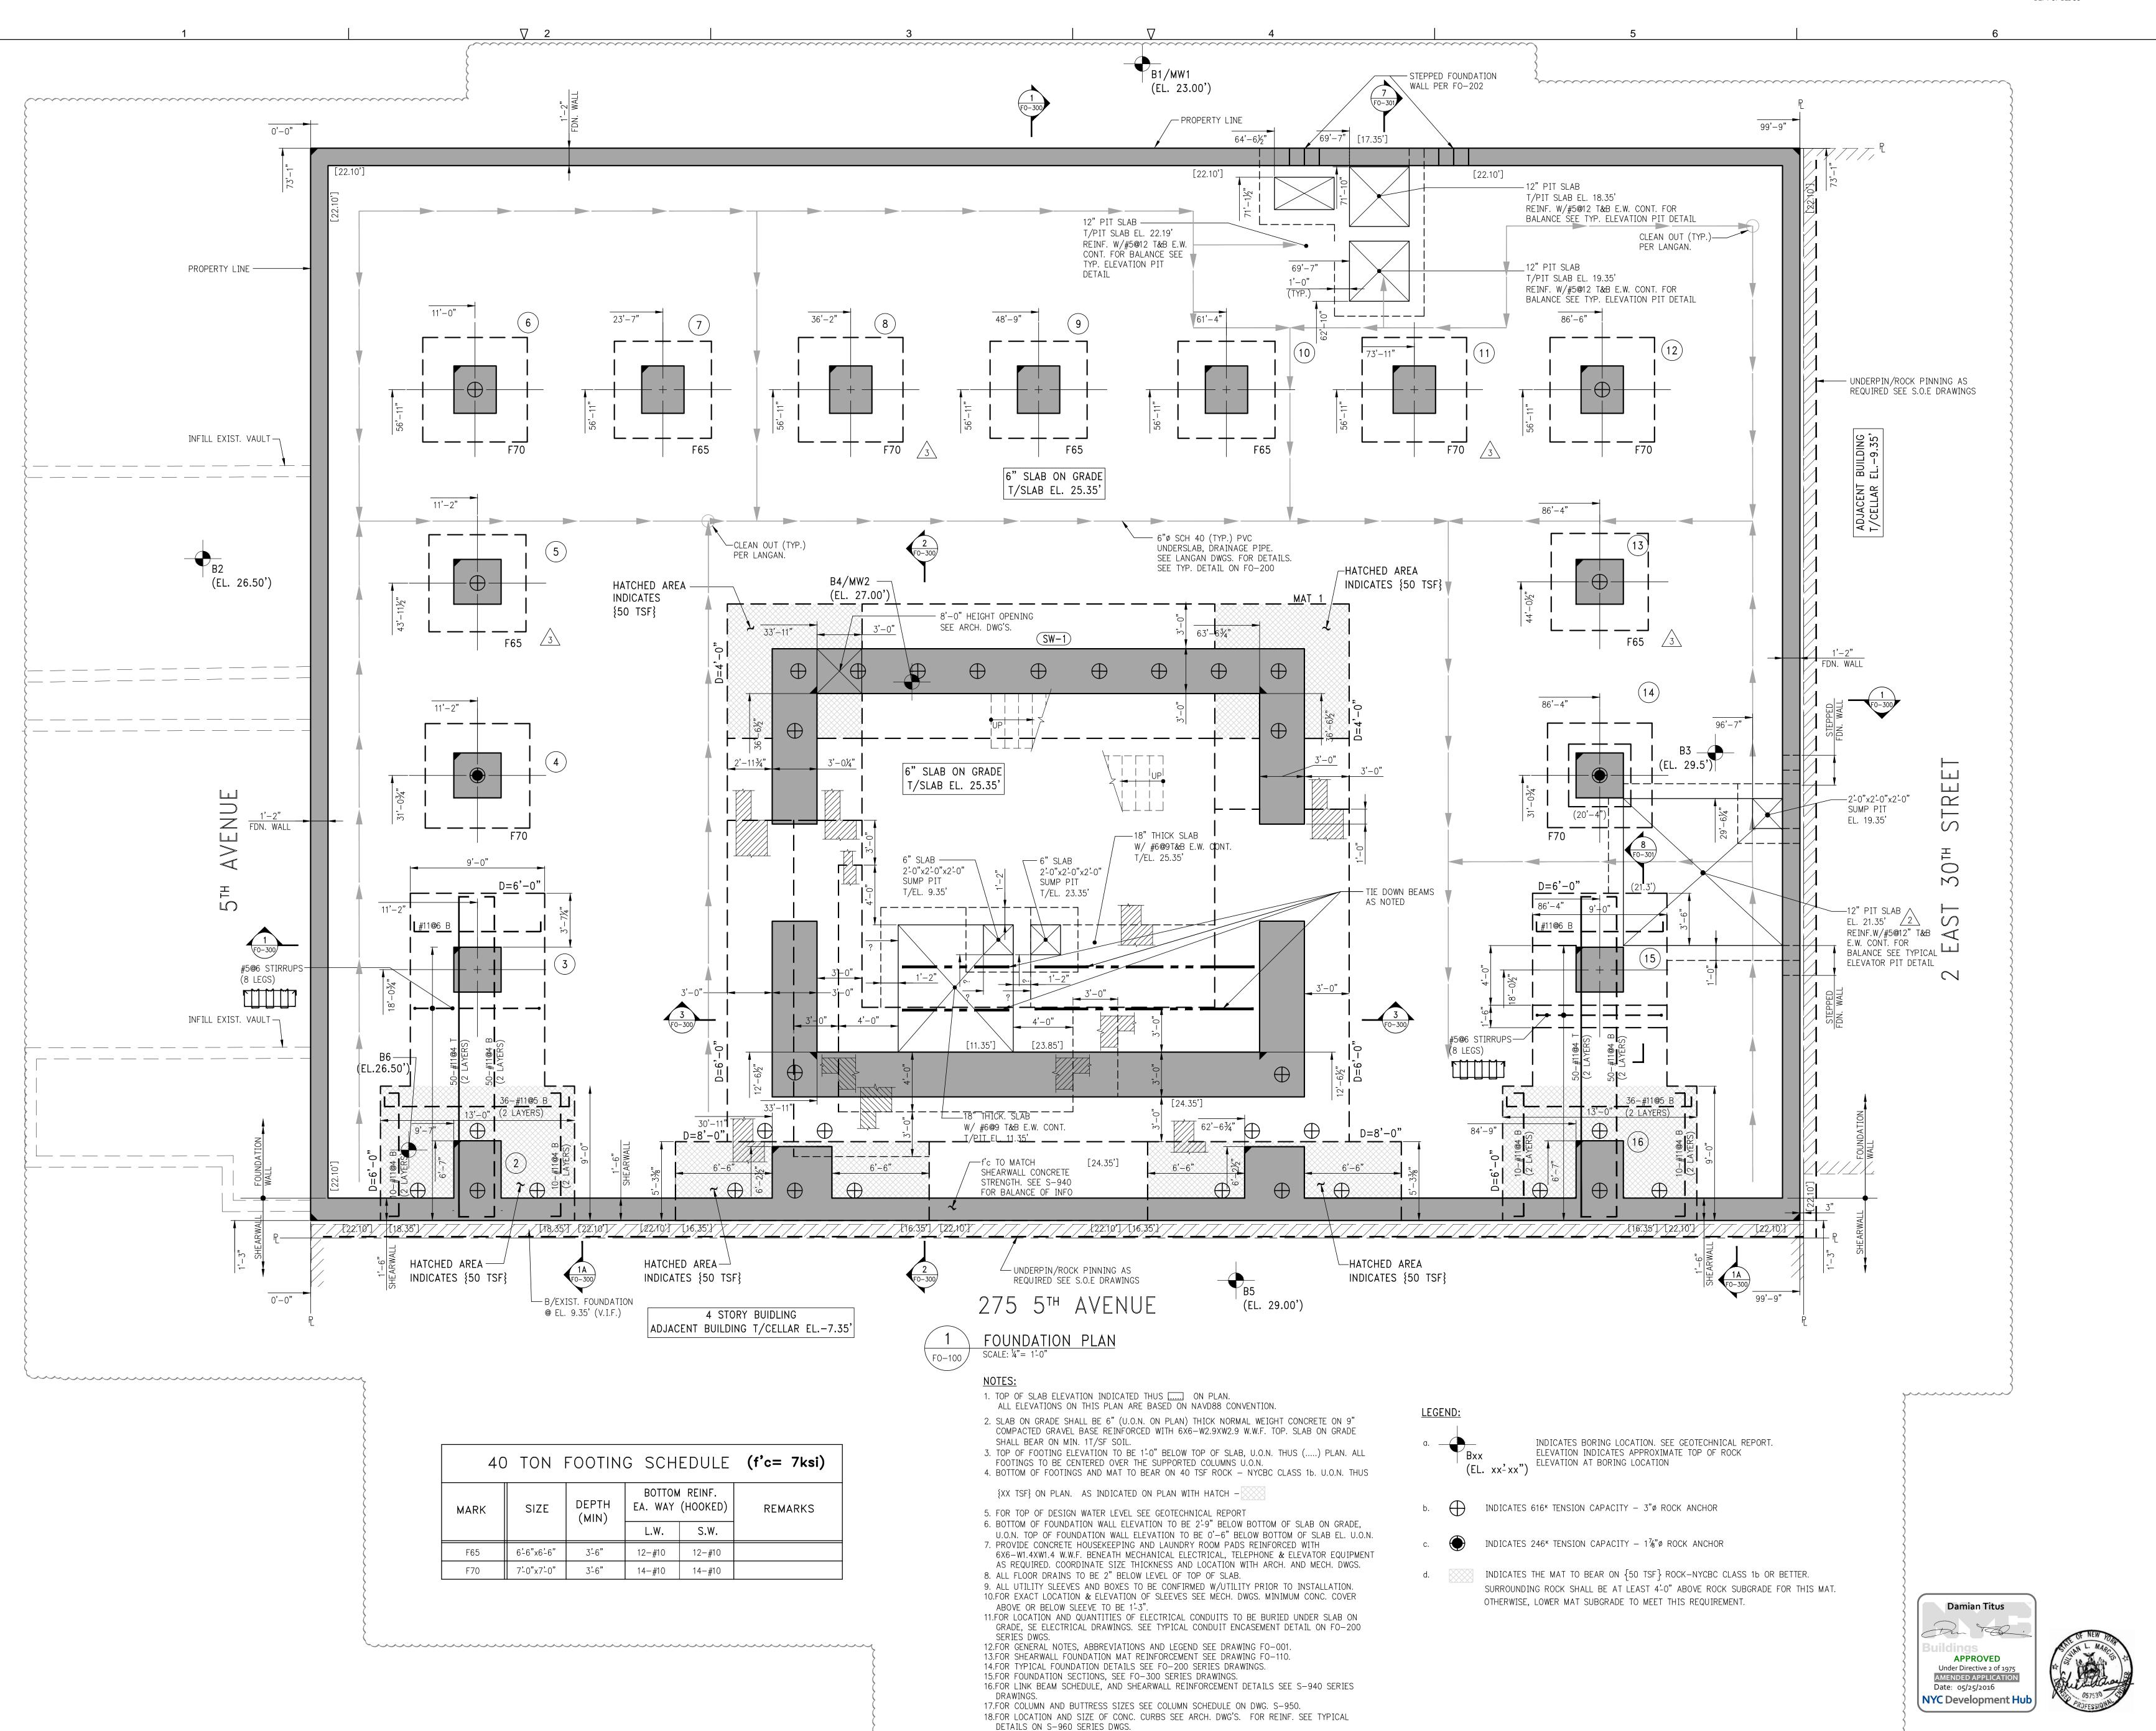

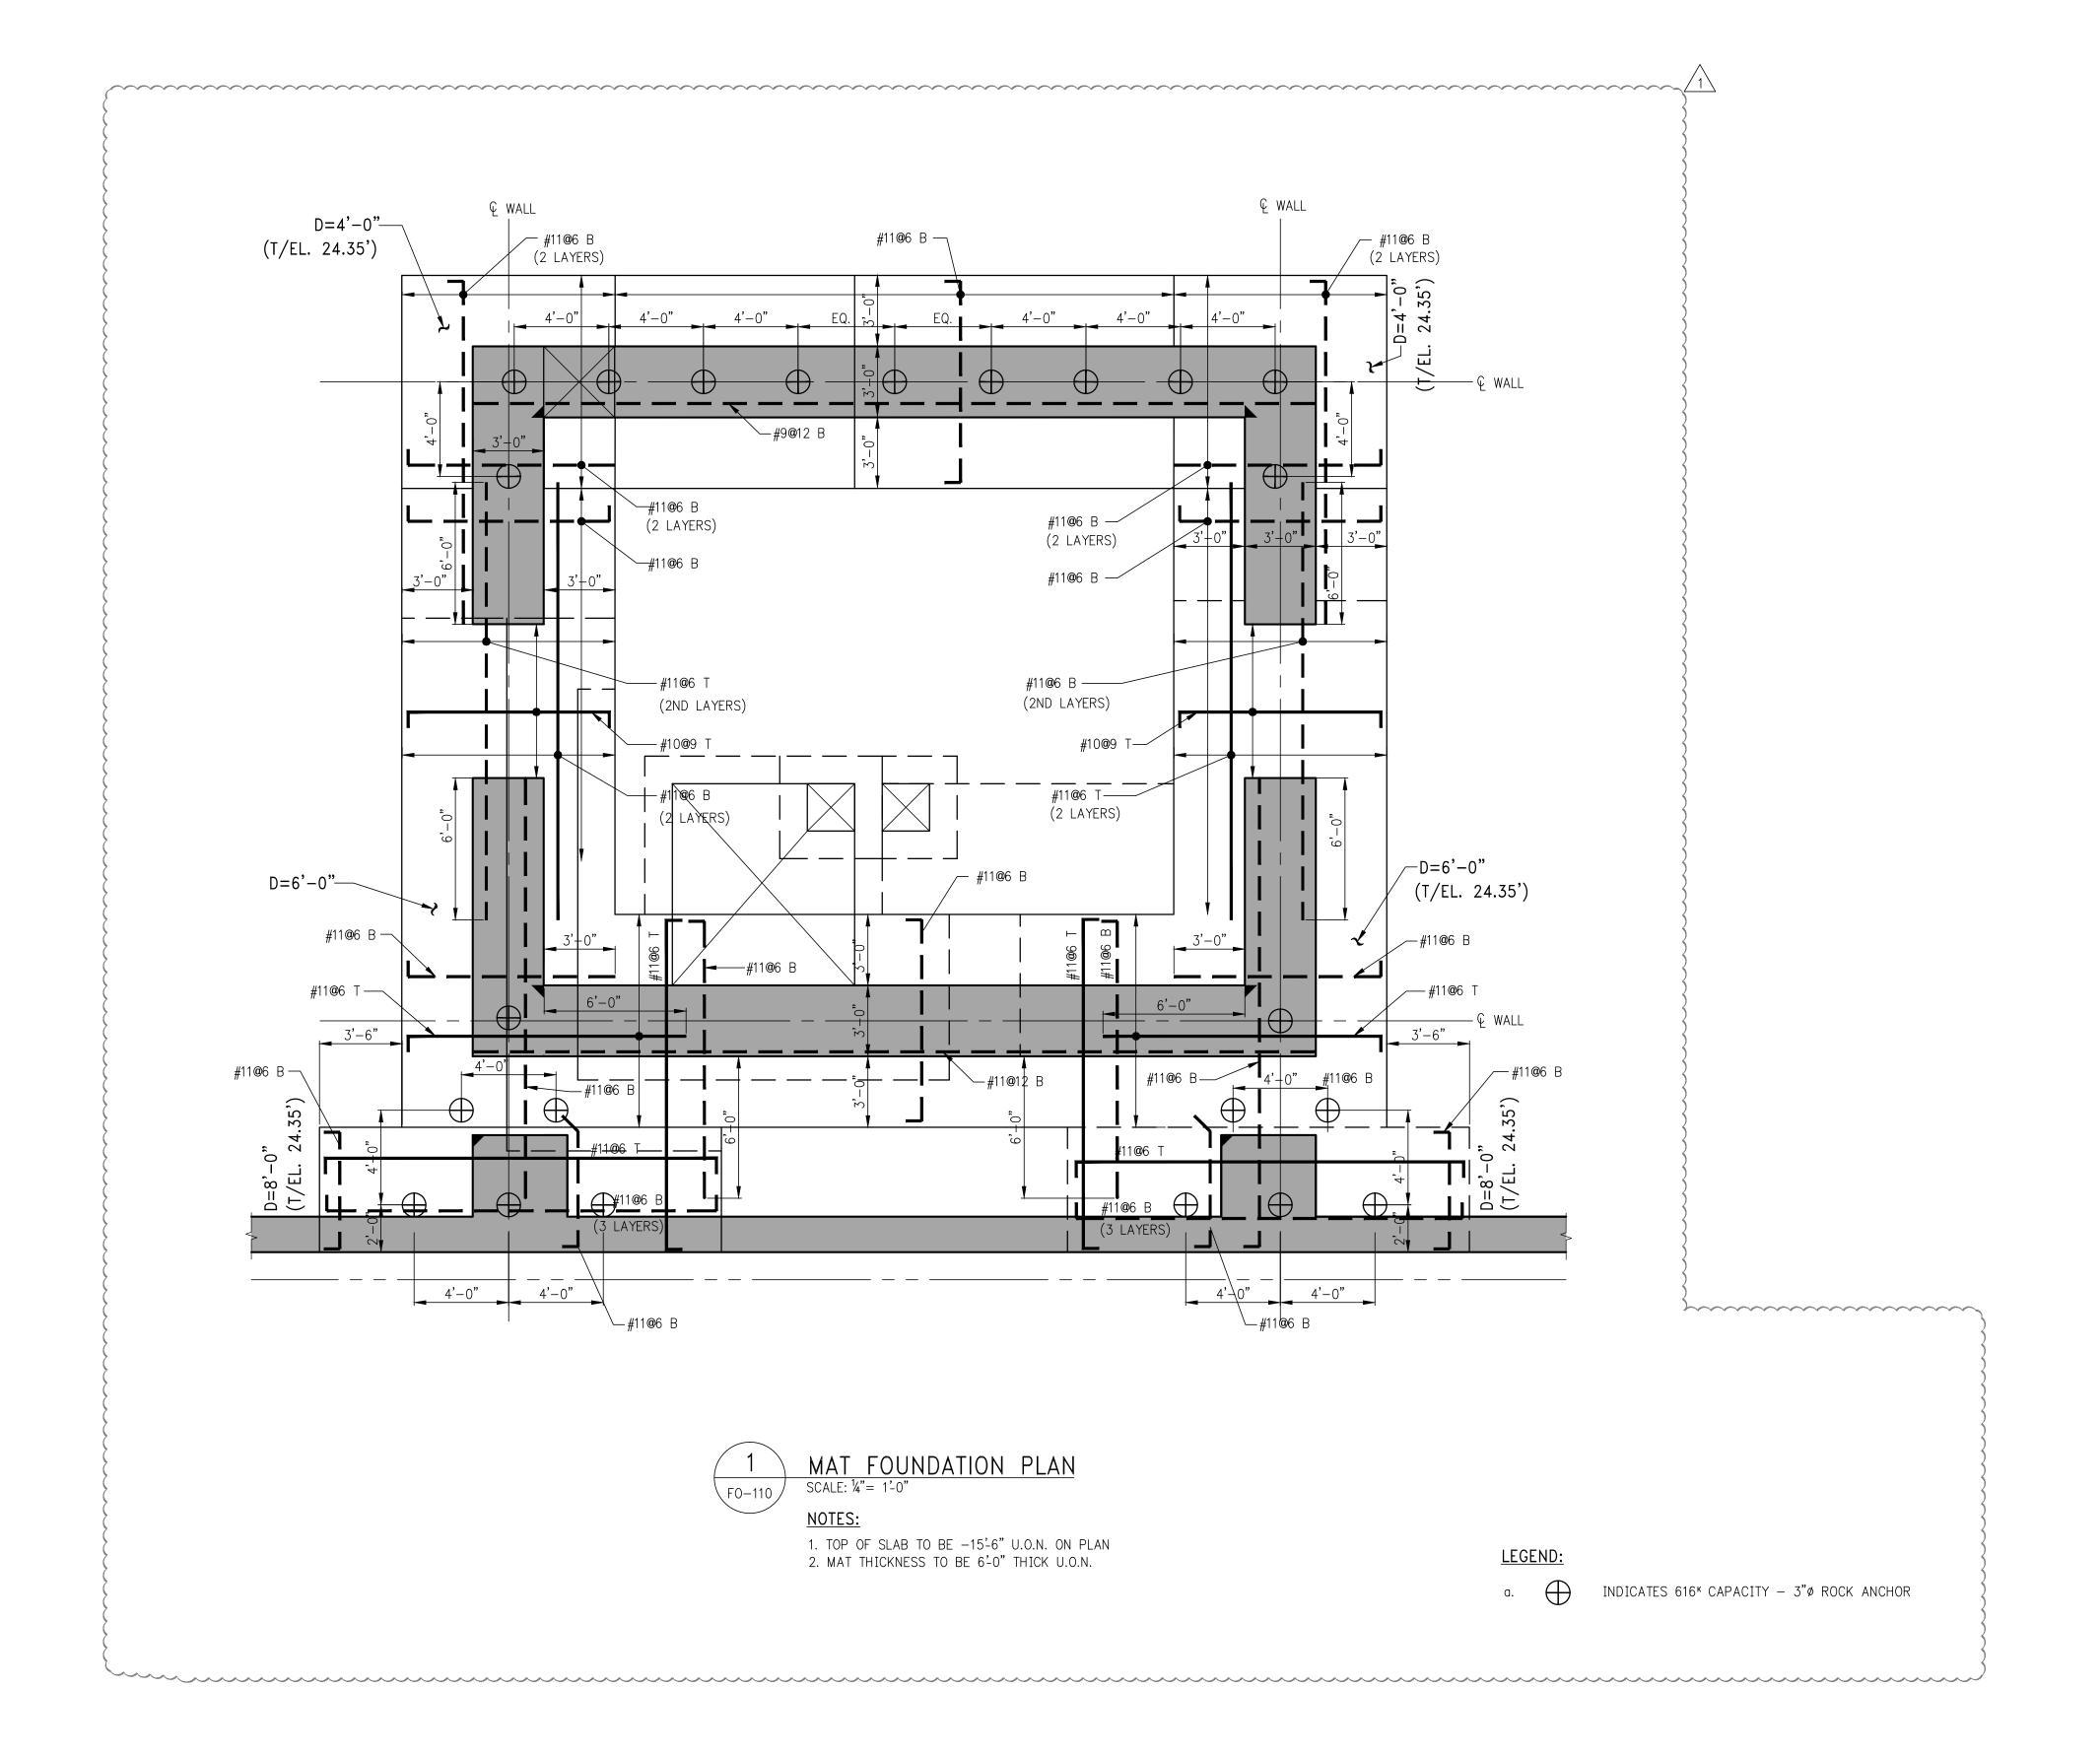

28 Fifth Avenue

OWNER:

VICTOR NOMAD LLC

CONSTRUCTION MANAGER:
LEND LEASE
200 PARK AVENUE, 9TH FLOOR

NEW YORK, NY 10166

TEL: 212 592 6700

ARCHITECT:
RAFAEL VIÑOLY ARCHITECTS PC
50 VANDAM STREET
NEW YORK NY 10013

NEW YORK, NY 10013 TEL: 212 924 5060 FAX: 212 924 5858 STRUCTURAL ENGINEER: WSP GROUP

228 EAST 45TH STREET, 3RD FLOOR NEW YORK, NY 10017 TEL: 212 687 9888

MEP/FP/IT ENGINEER:
MGE ENGINEERING
116 WEST 32ND STREET, 12TH FLOOR
NEW YORK, NY 10001
TEL: 212 643 9055

GEOTECH CIVIL ENGINEER: LANGAN ENGINEERING 300 KIMBALL DRIVE, 4TH FLOOR PARSIPPANY, NJ, 07054 TEL: 973 560 4900

VERTICAL TRANSPORT. CONSULTANT: VAN DEUSEN & ASSOCIATES 120 EAGLE ROCK AVENUE, SUITE 310 EAST HANOVER, NJ, 07936 TEL: 973 994 9220

ENCLOSURE CONSULTANT: VIDARIS, INC. 360 PARK AVENUE SOUTH, 15TH FLOOR NEW YORK, NY, 10010 TEL: 212 689 5389

FACADE MAINTENANCE CONSULTANT: ENTEK ENGINEERING LLC 166 AMES STREET HACKENSACK, NJ, 07601 TEL: 201 820 2801

ACOUSTICAL CONSULTANT: CERAMI & ASSOCIATES 404 FIFTH AVENUE NEW YORK, NY, 10018 TEL: 212 616 4179

LIGHTING CONSULTANT:
ONE LUX STUDIO
158 WEST 29TH STREET, 10TH FLOOR
NEW YORK, NY, 10001
TEL: 212 201 5790

SPECIFICATIONS CONSULTANT: ROBERT SCHWARTZ & ASSOCIATES 589 EIGHTH AVENUE, 17TH FLOOR NEW YORK, NY, 10018 TEL: 212 691 3248

ENERGY MODELING CONSULTANT: STEVEN WINTER ASSOCIATES, INC 307 SEVENTH AVENUE, SUITE 1701 NEW YORK, NY, 10001 TEL: 212 564 5800

INTERIOR DESIGN CONSULTANT:
JEFFREY BEERS INTERNATIONAL
156 5TH AVENUE, PENTHOUSE 2
NEW YORK, NY, 10010
TEL: 212 352 2020

DESIGN DEVELOPMENT
NYC DEPT. OF BUILDINGS SUBMITTAL

ARCHITECT'S SEAL

04/29/2016 DOB FOUNDATION PAA #1

04/08/2016 DOB SUBMITTAL
04/08/2016 SUPERSTRUCTURE EARLY BID
03/25/2016 DOB FOUNDATION POST


APPROVAL AMENDMENT

01/27/2016 FOUNDATION BID ADD. #1

01/18/2016 FOUNDATION BID

O1/18/2016 FOUNDATION BID
ISSUE ISSUE DESCRIPTION
NO. DATE

30TH STREET

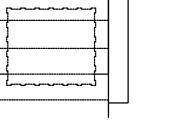

IF THIS DRAWING IS NOT 42" X 30" IT IS
A REDUCED PRINT;
REFER TO GRAPHIC SCALE

SCALE

APPROVED
Under Directive 2 of 1975
AMENDED APPLICATION
Date: 05/25/2016

NYC Development Hub

1/4" = 1'-0"


MAT FOUNDATION PLAN

SHEET TITLE :

FN_110 (

SHEET NUMBER :

FU-110

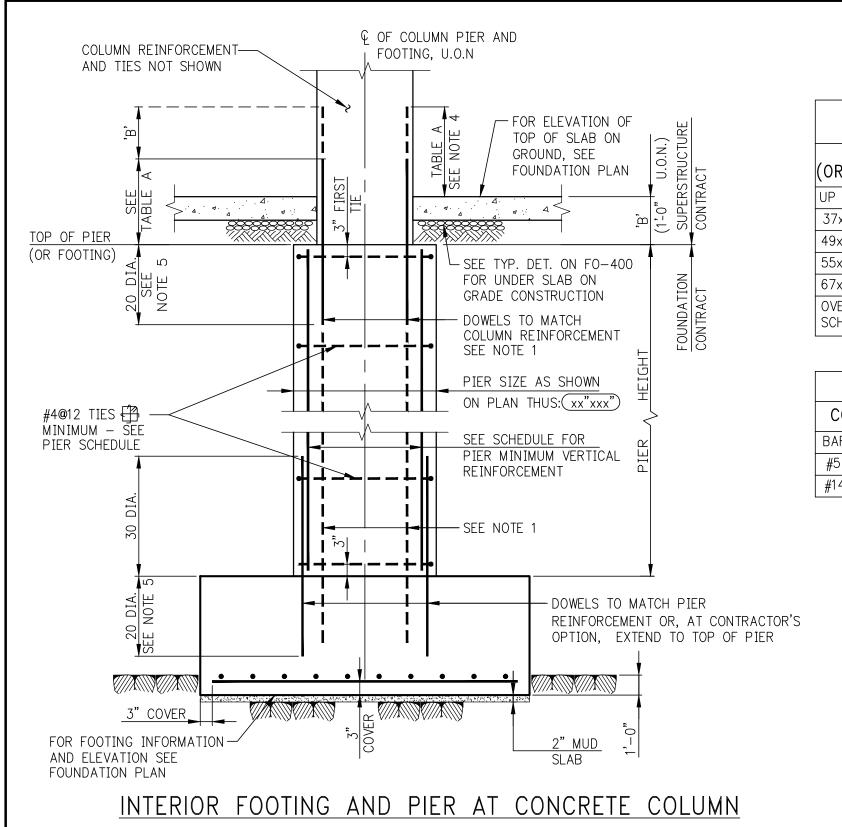

THIS DETAIL DOES NOT APPLY WHERE COLUMN

1. WHERE PIER HEIGHT IS LESS THAN EMBEDMENT LENGTH OF COLUMN DOWELS, EMBED DOWELS IN FOOTING AND

2. AT CONTRACTOR'S OPTION, A SHORT PIER MAY BE ELIMINATED BY THICKENING THE COLUMN FOOTING TO

3. MAXIMUM PIER HEIGHT TO BE EIGHT TIMES THE LEAST PIER DIMENSION. INCREASE PIER SIZE AS REQUIRED

4. WHEN SLAB ON GROUND IS POURED BEFORE COLUMN, INCREASE LENGTH OF DOWELS BY DIMENSION 'B' (FROM

5. IF GRADE 75 COLUMN REINFORCEMENT IS USED, INCREASE DOWEL EMBEDMENT LENGTH TO 24 DIAMETERS.

6. MINIMUM CONCRETE STRENGTH OF f'c=4,000 PSI IS REQUIRED FOR PIER AND FOOTING. SEE PLANS AND

_

ROCK ANCHOR DETAIL

FOR ROCK ANCHOR GENERAL NOTES SEE PROJECT SPECIFICATION

FOR ANCHOR INSTALLATION AND TESTING REQUIREMENTS.

PVC SHEATHING

GROUT

TOP OF PIER TO TOP OF SLAB.) IN ADDITION, IF COLUMN CONCRETE STRENGTH IS GREATER THAN 1.4 TIMES

SLAB CONCRETE STRENGTH, THE SLAB CONCRETE STRENGTH MUST BE INCREASED LOCALLY TO MATCH COLUMN

REINFORCEMENT IS IN TENSION.

CONCRETE STRENGTH FOR A DISTANCE OF 2 FEET IN ALL DIRECTIONS FROM COLUMN FACES.

EXTEND THROUGH PIER INTO COLUMN ABOVE.

NOTES FOR GREATER STRENGTH REQUIREMENTS.

THE TOP OF PIER ELEVATION.

TO MAINTAIN THIS RATIO.

PIER: MINIMUM VERTICAL | NOTE: THE PIER SCHEDULE MAY REQUIRE A VERTICAL | GREATER AMOUNT OF PIER SIZE REINF. | REINFORCEMENT, BUT (OR EQUIVALENT) NOT LESS. UP TO 36x36 37x37 TO 48x48 12-#6 49x49 TO 54x54 12-#7 55x55 TO 66x66 16-#7 67x67 TO 84x84 16-#8 OVER 84 TO BE SUPPLIED IN PIER SCHEDULE


TABLE A COMPRESSION LAP SPLICE LENGTH fy=60 KSI fy=75 KSI #5 TO #11 | 30 DIA. 44 DIA. #14 & #18 |45"-#11 DOWELS |60"-#11 DOWELS


WALL OR COLUMN BOTT. OF EXIST.— CUT BACK ANY-2" MIN. DRYPACK FOOTING EXIST. PROJECTION & STEEL SHIMS EXTEND SLAB TO — UNDERPINNING STONE EXISTING WALL OR CONCRETE UNDERPINNING WHERE NEW WALL DOES NOT WIDTH OF UNDERPINNING OCCUR. AT LEAST EQUAL TO WIDTH OF WALL FOOTING ABOVE BOTT. OF -UNDERPINNING ELEVATION BEARING MATERIAL TO BE EQUAL TO -OR STRONGER THAN MATERIAL SUPPORTING EXISTING FOUNDATION, LOWER BOTTOM OF UNDERPINNING AND NEW FOUNDATION IF REQUIRED BY SITE CONDITIONS

1. EXCAVATE & PLACE PANELS IN ORDER SHOWN. 2. MINIMUM CLEAR DISTANCE BETWEEN SIMULT. CUTS TO BE 12'-0" 3. CONCRETE FOR UNDERPINNING TO BE CONTROLLED STONE CONCRETE 3000 P.S.I.

SUGGESTED UNDERPINNING DETAIL

- 1. THIS DETAIL IS REPRESENTATIVE OF ONE METHOD OF UNDERPINNING UNDER PARTICULAR CIRCUMSTANCES. THE CONTRACTOR MUST EVALUATE THIS PROJECT AND DETERMINE EXACT METHODS AND PROCEDURES TO BE FOLLOWED.
- 2. CONTRACTOR'S UNDERPINNING DESIGN ENGINEER SHALL BE A REGISTERED PROFESSIONAL ENGINEER IN THE STATE OF NEW YORK AND SHALL REVIEW ALL AVAILABLE BORING DATA AND EXISTING CONDITIONS TO DETERMINE THE NECESSITY OF PRELOADING AND/OR JACKPILING TO PROTECT ADJACENT STRUCTURES PRIOR TO COMMENCEMENT
- OF UNDERPINNING OPERATIONS. 3. THE CONTRACTOR'S PROFESSIONAL ENGINEER SHALL FILE WITH THE BUILDING DEPARTMENT THE SELECTED

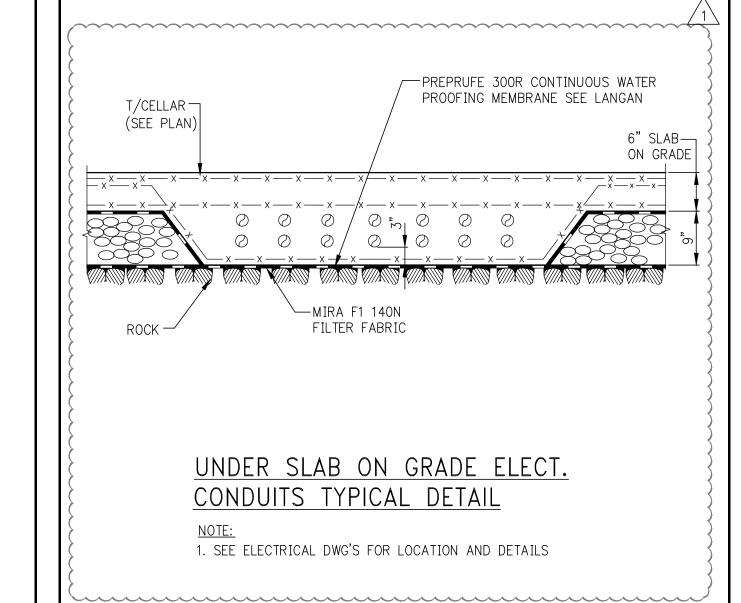

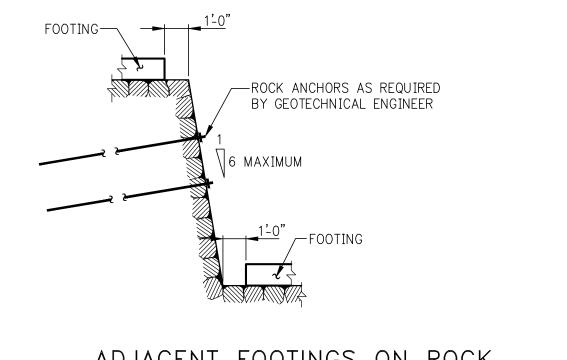


<u>SECTION</u>


NEW BUILDING ---

ADJACENT FOOTINGS ON ROCK AT DIFFERENT ELEVATIONS

FOR ROCK CAPACITY = 20 TONS PER SQ. FT. OR HIGHER.

THIS DETAIL IS SUBJECT TO THE INTEGRITY OF THE ROCK AND PITCH OF ROCK SEAMS AND MAY BE MODIFIED DUE TO SITE CONDITIONS. MAXIMUM HEIGHT DIFFERENTIAL TO BE DETERMINED BY GEOTECHNICAL ENGINEER WHEN ACTUAL ROCK CONDITION

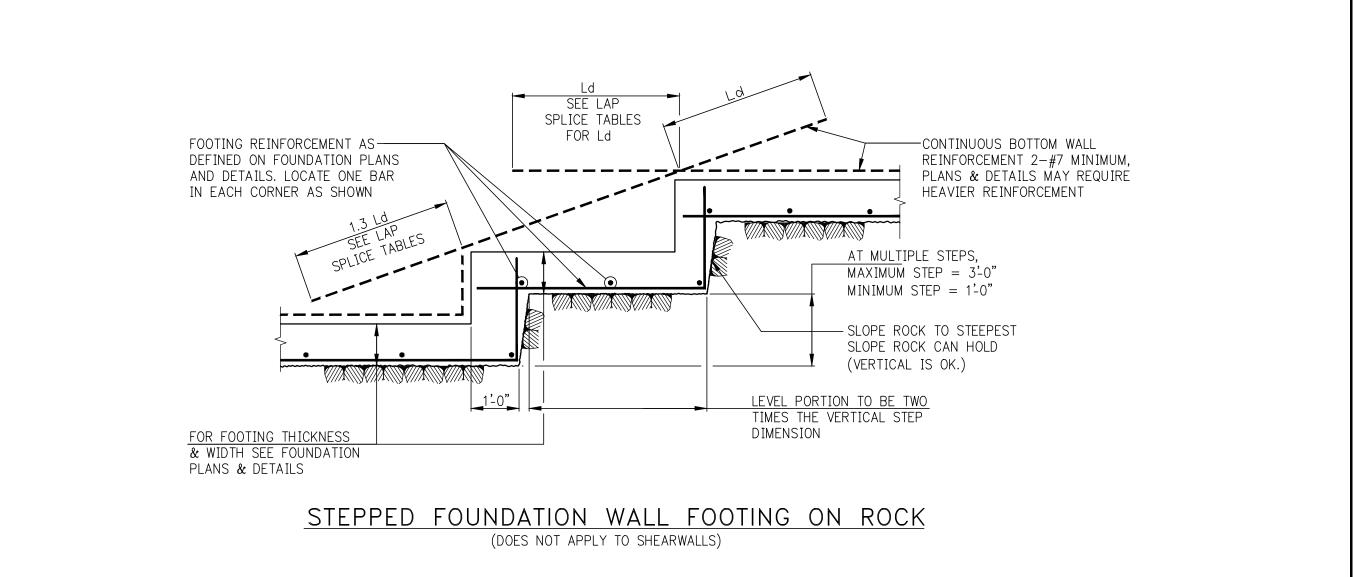

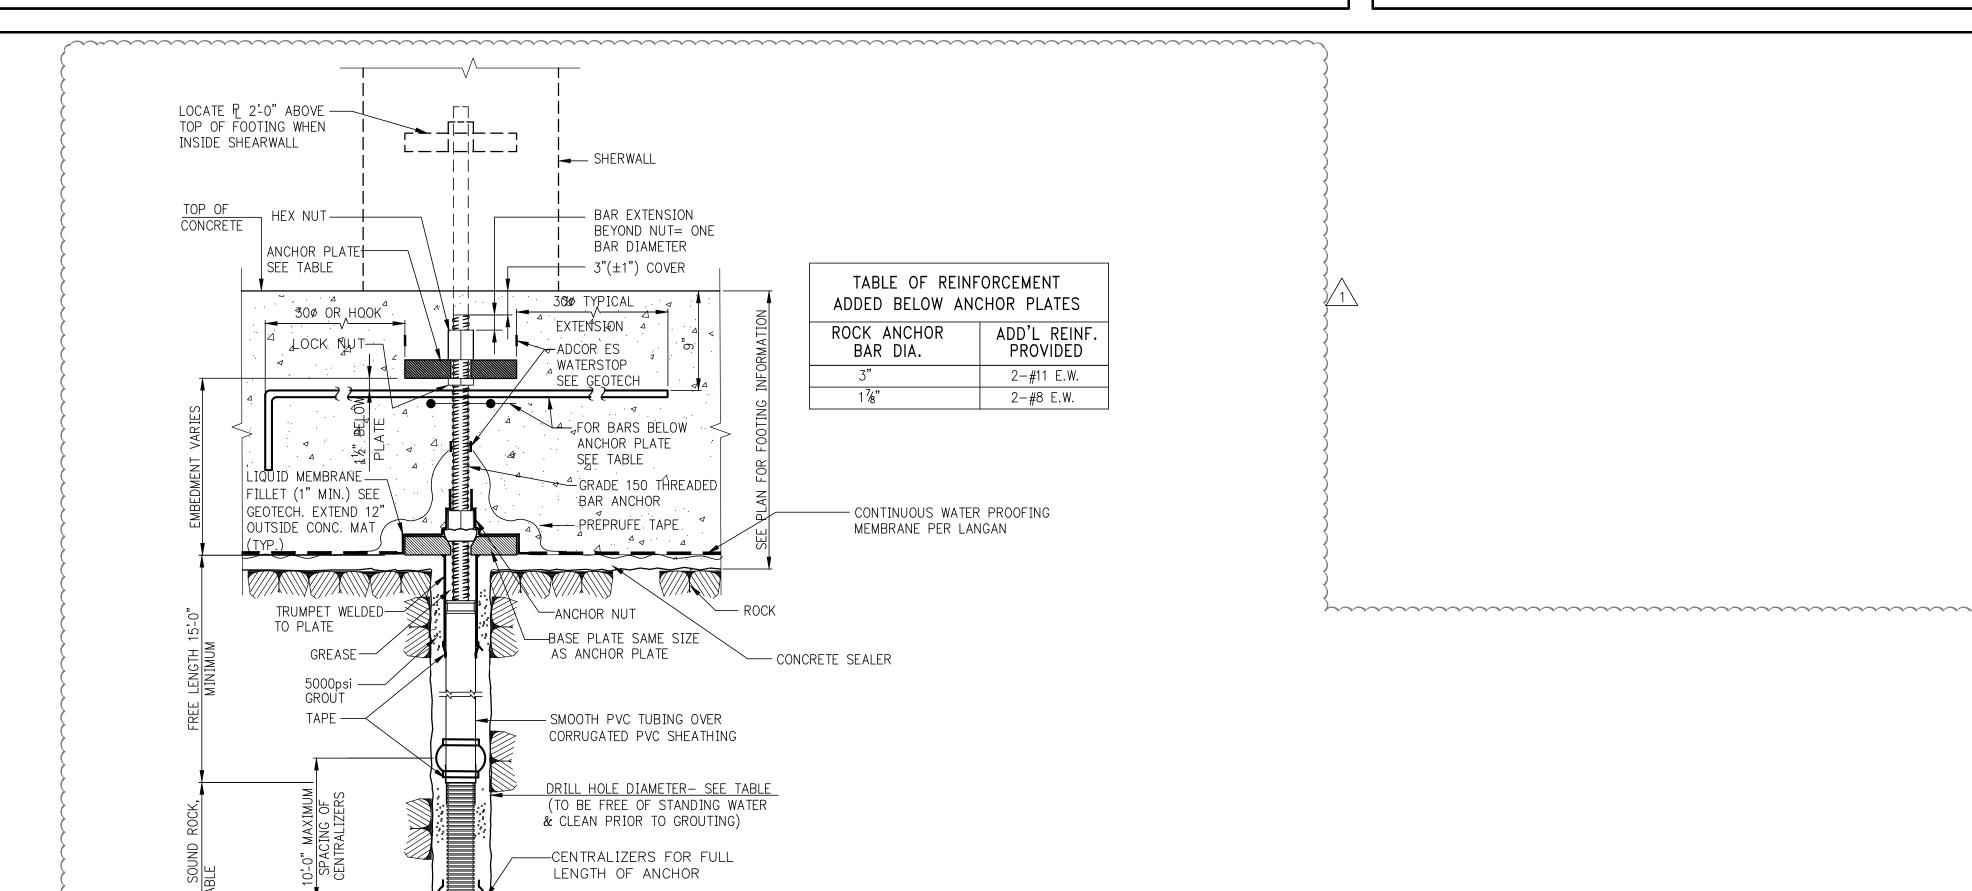

·CORRUGATED

SECTION A-A


RECOMMENDED GROUT MIX

1 BAG - PORTLAND CEMENT TYPE III


PVC SHEATHING

5 GALLONS — POTABLE WATER

1/2 LB. SIKA ENTRAPLAST "N"

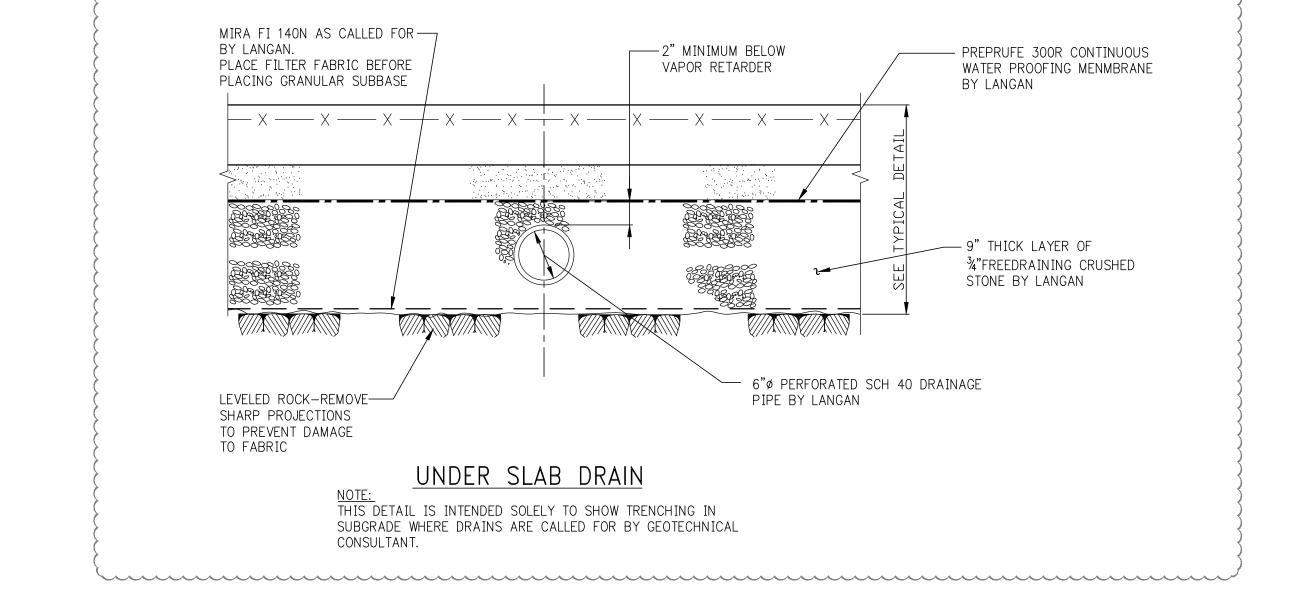

/1

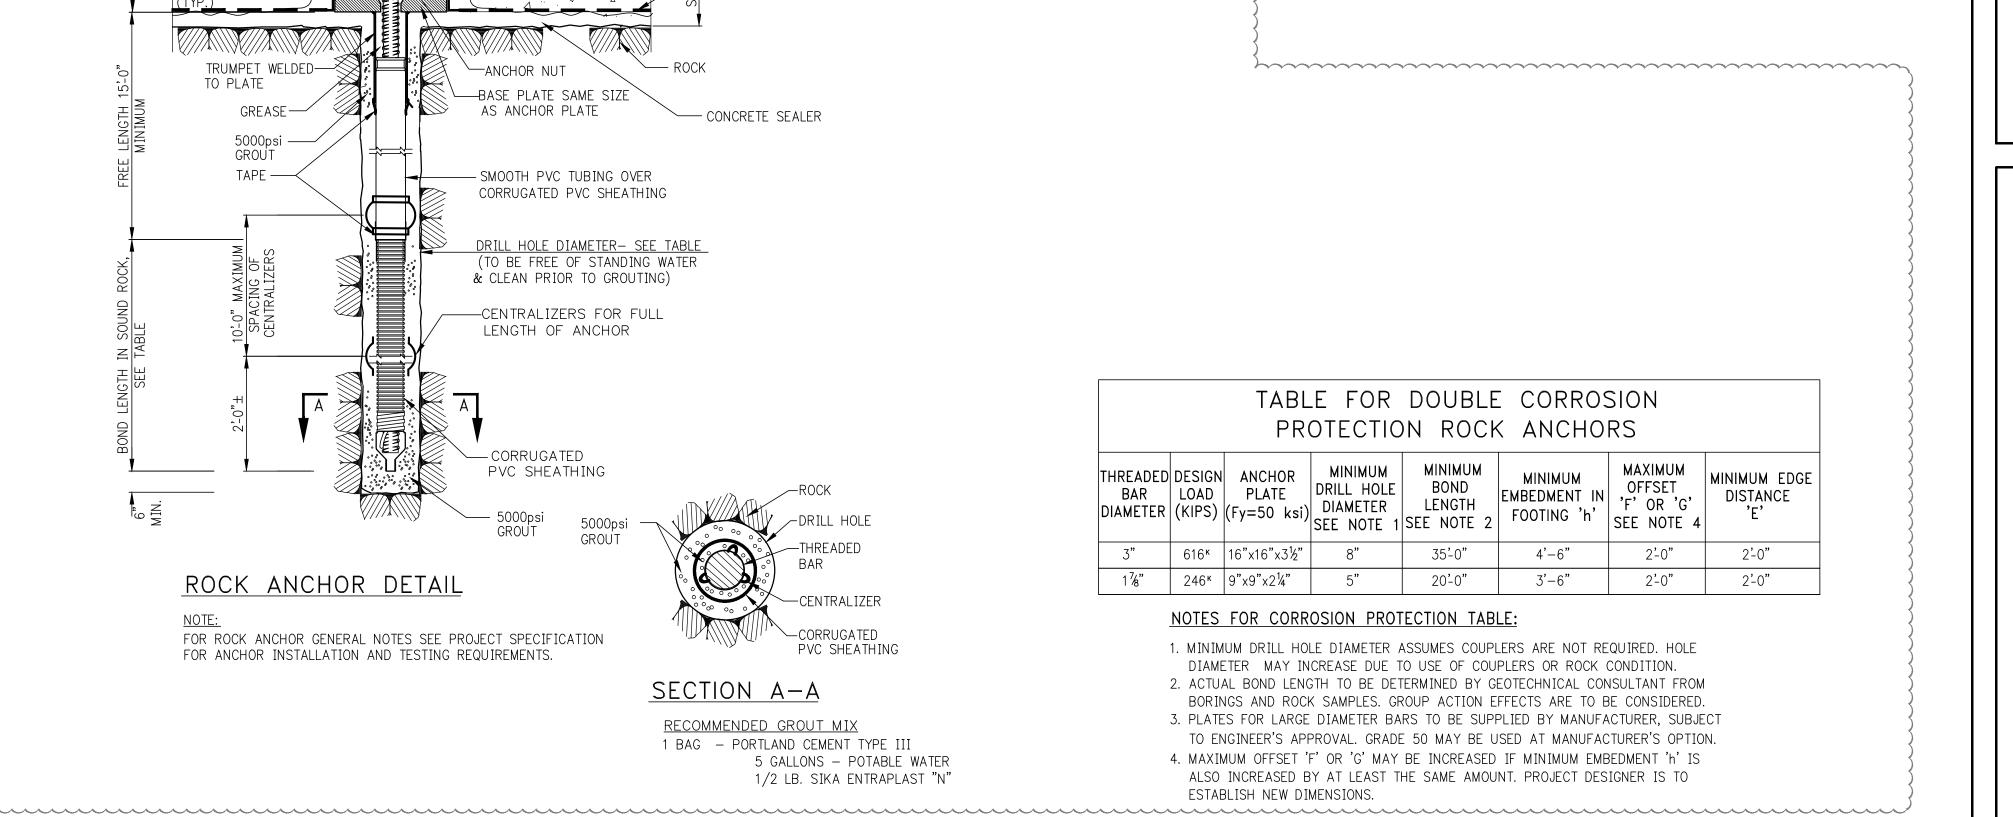

MINIMUM

20'-0"

FOOTING 'h'

3'-6"

MINIMUM

NOTES FOR CORROSION PROTECTION TABLES

THREADED DESIGN ANCHOR


3" | 616^k | 16"x16"x3½"

1⁷/₈" | 246^k |9"x9"x2¹/₄"

BAR LOAD PLATE DRILL HOLE

DIAMETER (KIPS) (Fy=50 ksi) DIAMETER | LENGTH | SEE NOTE 2

ESTABLISH NEW DIMENSIONS.

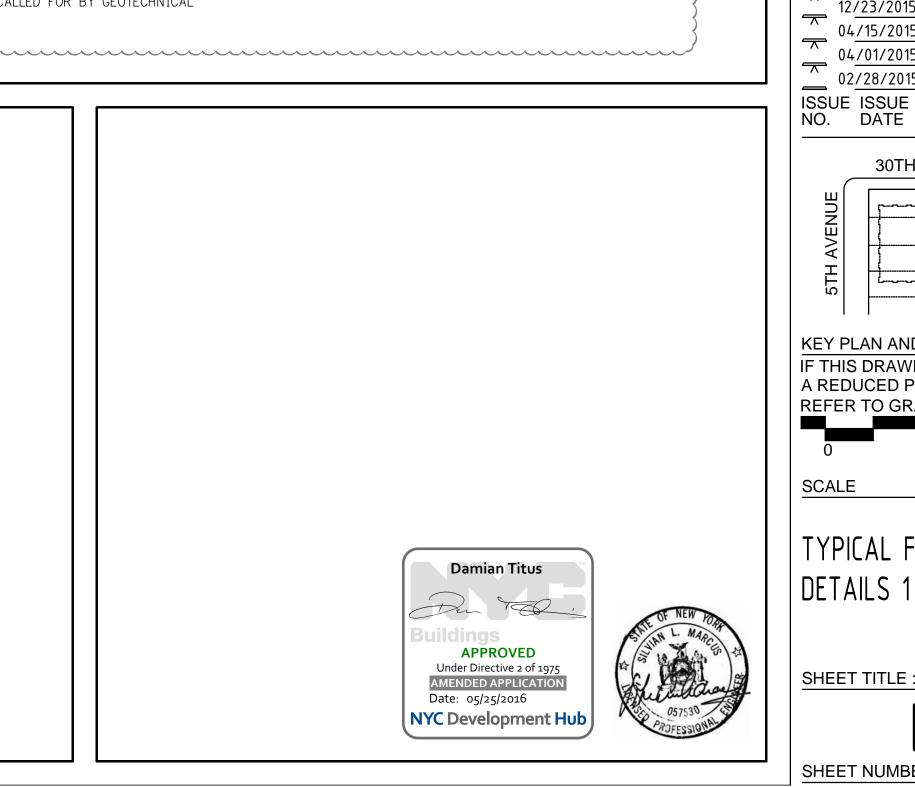

NEW YORK, NY

OWNER: VICTOR NOMAD LLC

TEL: 212 592 6700

TEL: 212 687 9888

CONSTRUCTION MANAGER: LEND LEASE 200 PARK AVENUE, 9TH FLOOR NEW YORK, NY 10166

ARCHITECT RAFAEL VIÑOLY ARCHITECTS PC **50 VANDAM STREET** NEW YORK, NY 10013 TEL: 212 924 5060 FAX: 212 924 5858

STRUCTURAL ENGINEER: WSP GROUP 228 EAST 45TH STREET, 3RD FLOOR NEW YORK, NY 10017

MEP/FP/IT ENGINEER: MGE ENGINEERING 116 WEST 32ND STREET, 12TH FLOOR NEW YORK, NY 10001

TEL: 212 643 9055 **GEOTECH CIVIL ENGINEER:** LANGAN ENGINEERING 300 KIMBALL DRIVE, 4TH FLOOR PARSIPPANY, NJ, 07054

TEL: 973 560 4900 **VERTICAL TRANSPORT. CONSULTANT:** VAN DEUSEN & ASSOCIATES 120 EAGLE ROCK AVENUE, SUITE 310

EAST HANOVER, NJ, 07936 TEL: 973 994 9220 **ENCLOSURE CONSULTANT:** VIDARIS, INC.

360 PARK AVENUE SOUTH, 15TH FLOOR NEW YORK, NY, 10010 TEL: 212 689 5389 FACADE MAINTENANCE CONSULTANT: ENTEK ENGINEERING LLC

HACKENSACK, NJ, 07601 TEL: 201 820 2801 ACOUSTICAL CONSULTANT: CERAMI & ASSOCIATES

166 AMES STREET

404 FIFTH AVENUE **NEW YORK, NY, 10018** TEL: 212 616 4179

LIGHTING CONSULTANT: ONE LUX STUDIO 158 WEST 29TH STREET, 10TH FLOOR NEW YORK, NY, 10001 TEL: 212 201 5790

SPECIFICATIONS CONSULTANT: ROBERT SCHWARTZ & ASSOCIATES 589 EIGHTH AVENUE, 17TH FLOOR NEW YORK, NY, 10018 TEL: 212 691 3248

ENERGY MODELING CONSULTANT: STEVEN WINTER ASSOCIATES, INC 307 SEVENTH AVENUE, SUITE 1701 NEW YORK, NY, 10001

INTERIOR DESIGN CONSULTANT: JEFFREY BEERS INTERNATIONAL 156 5TH AVENUE, PENTHOUSE 2 NEW YORK, NY, 10010 TEL: 212 352 2020

DESIGN DEVELOPMENT NYC DEPT. OF BUILDINGS SUBMITTAL

ARCHITECT'S SEAL

TEL: 212 564 5800

04/29/2016 DOB FOUNDATION PAA #1 04/08/2016 DOB SUBMITTAL


04/08/2016 SUPERSTRUCTURE EARLY BID

03/25/2016 DOB FOUNDATION POST APPROVAL AMENDMENT

01/27/2016 FOUNDATION BID ADD. #1 01/18/2016 FOUNDATION BID

12/23/2015 SCHEMATIC DESIGN 04/15/2015 DOB SUBMITTAL 04/01/2015 FOUNDATION BID

02/28/2015 SCHEMATIC DESIGN ISSUE ISSUE DESCRIPTION

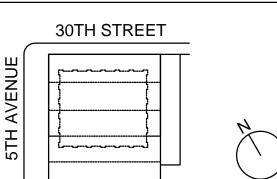


KEY PLAN AND NORTH SIGN IF THIS DRAWING IS NOT 42" X 30" IT IS A REDUCED PRINT;


N.T.S

REFER TO GRAPHIC SCALE

TYPICAL FOUNDATION DETAILS 1

SHEET TITLE:

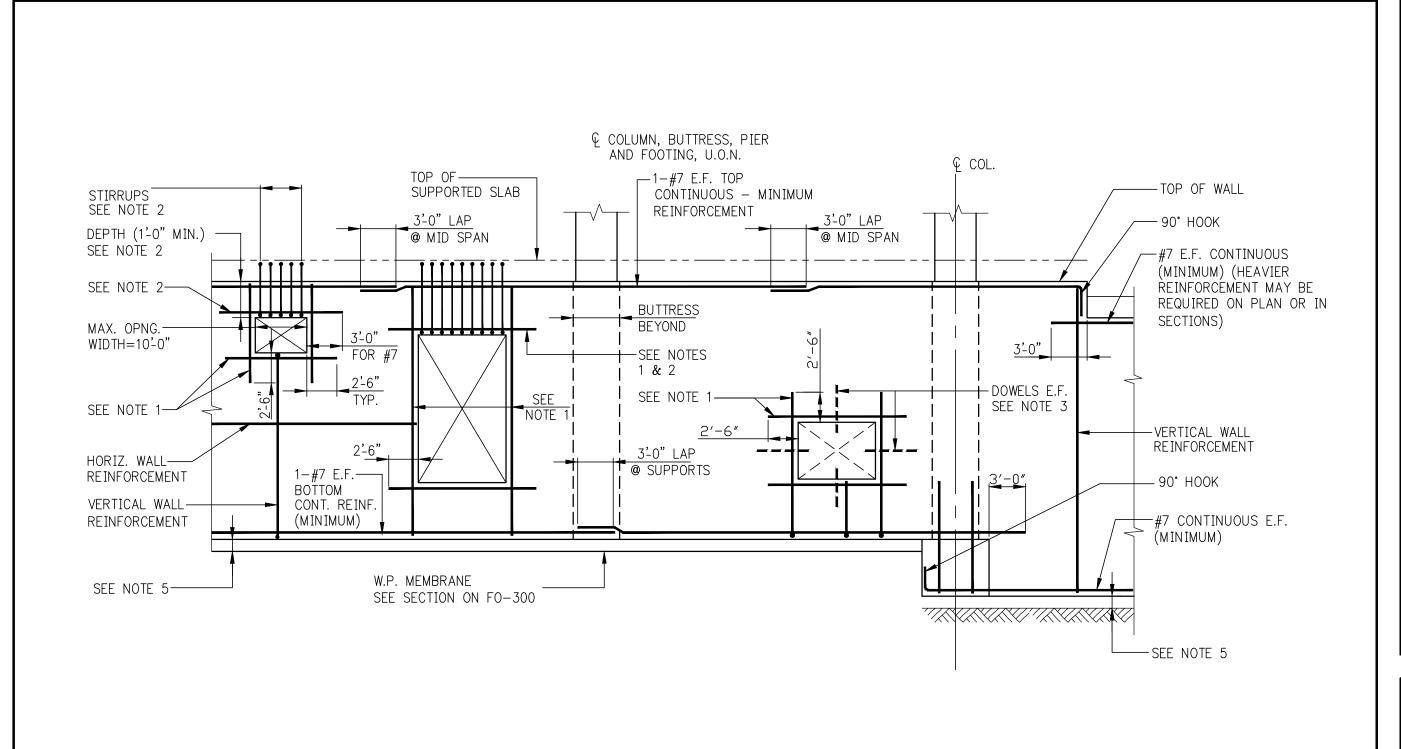

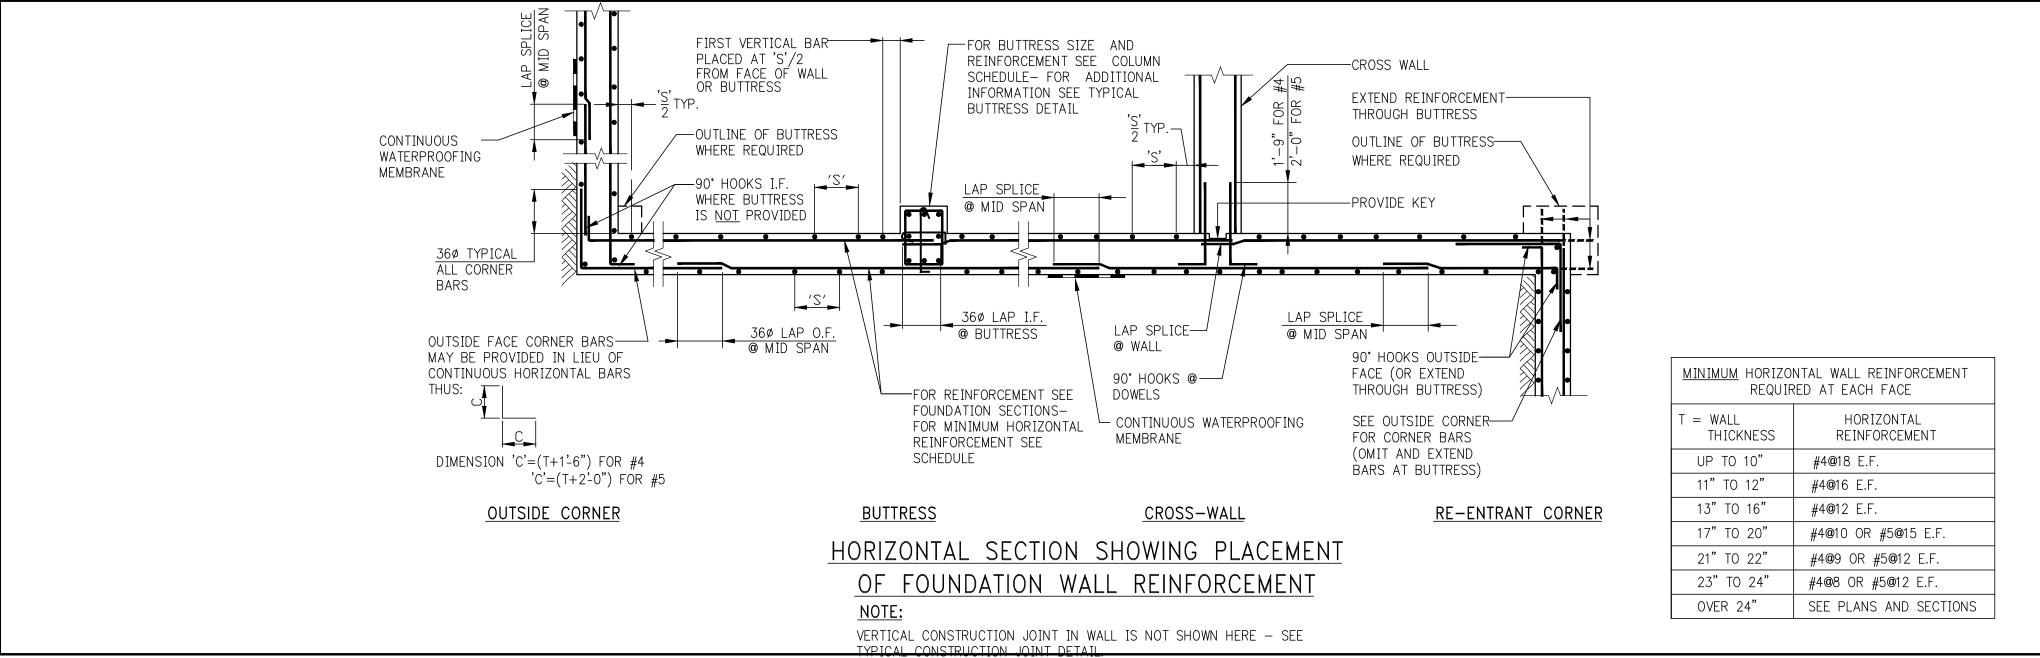





1. ADD #5 BARS (HORIZ. & VERT.) AT ALL FOUR EDGES OF OPENINGS. AREA OF ADDED BARS AT EACH EDGE TO BE EQUAL TO ONE HALF OF AREA OF INTERRUPTED BARS IN THE CORRESPONDING DIRECTION. PROVIDE A MINIMUM OF 1-#5 E.F.


2. WHERE TOP EDGE OF OPENING IS LESS THEN 2'-6" FROM TOP OF WALL ADD 1-#7 E.F. (IN LIEU OF #5) OVER OPENING. PROVIDE #4 ☐ STIRRUPS @ 8" — EXTEND INTO SLAB WITH 2" COVER AT TOP OF STIRRUPS.


3. AT UTILITY ACCESS OPENINGS WHICH ARE TO BE FILLED IN WITH CONCRETE, PROVIDE DOWELS PROJECTING 1'-0" INTO OPENING. EITHER EXTEND HORIZONTAL AND VERTICAL WALL REINFORCEMENT, OR ADD # 4@12± E.F. DOWELS x2-6" LONG.

W. W. F. ──

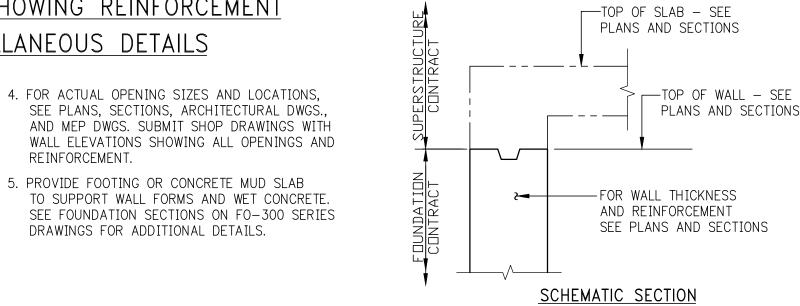


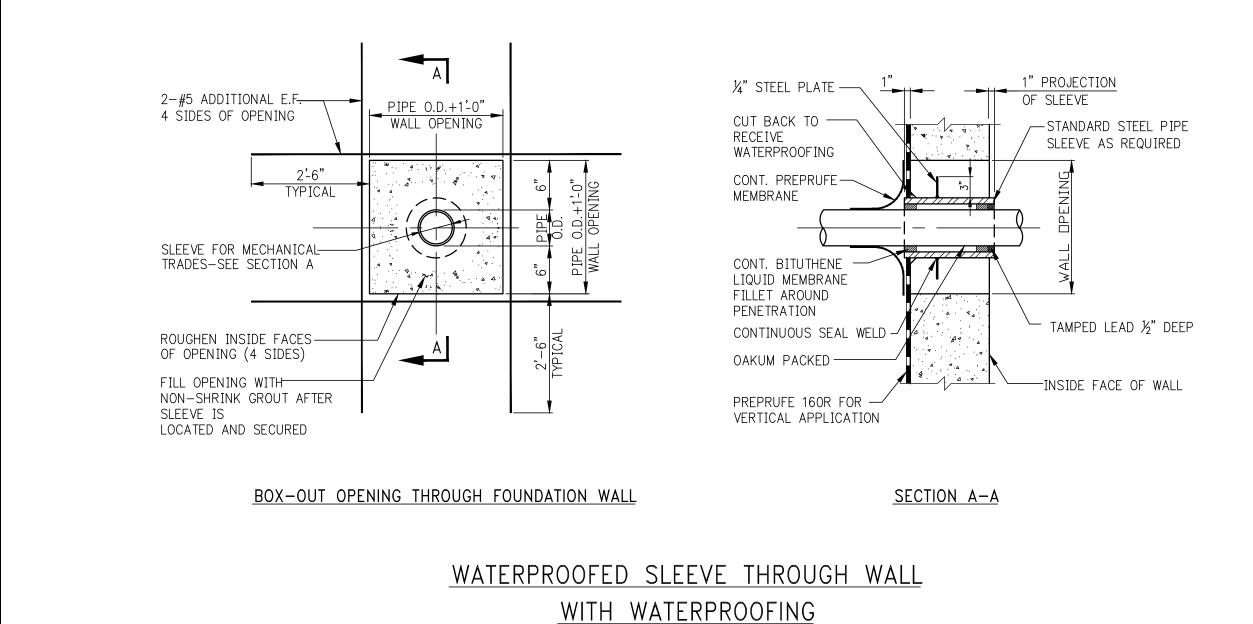


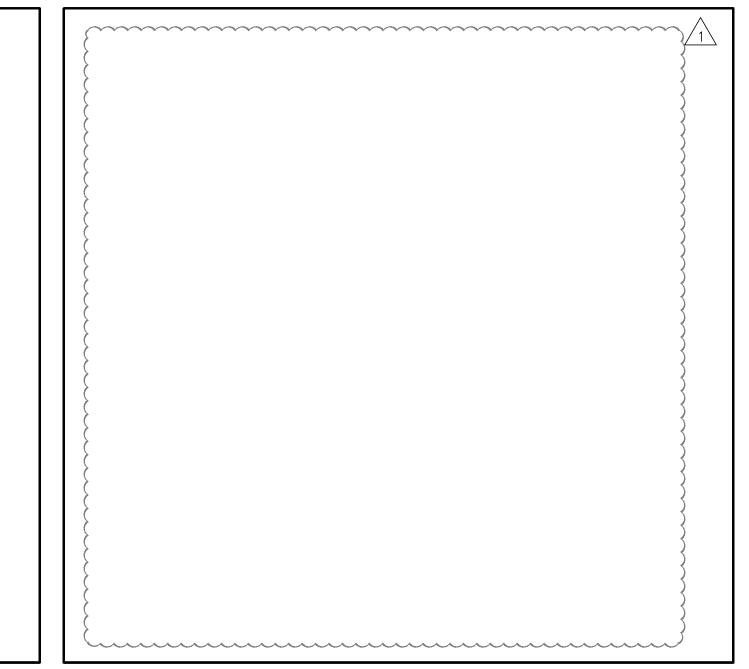


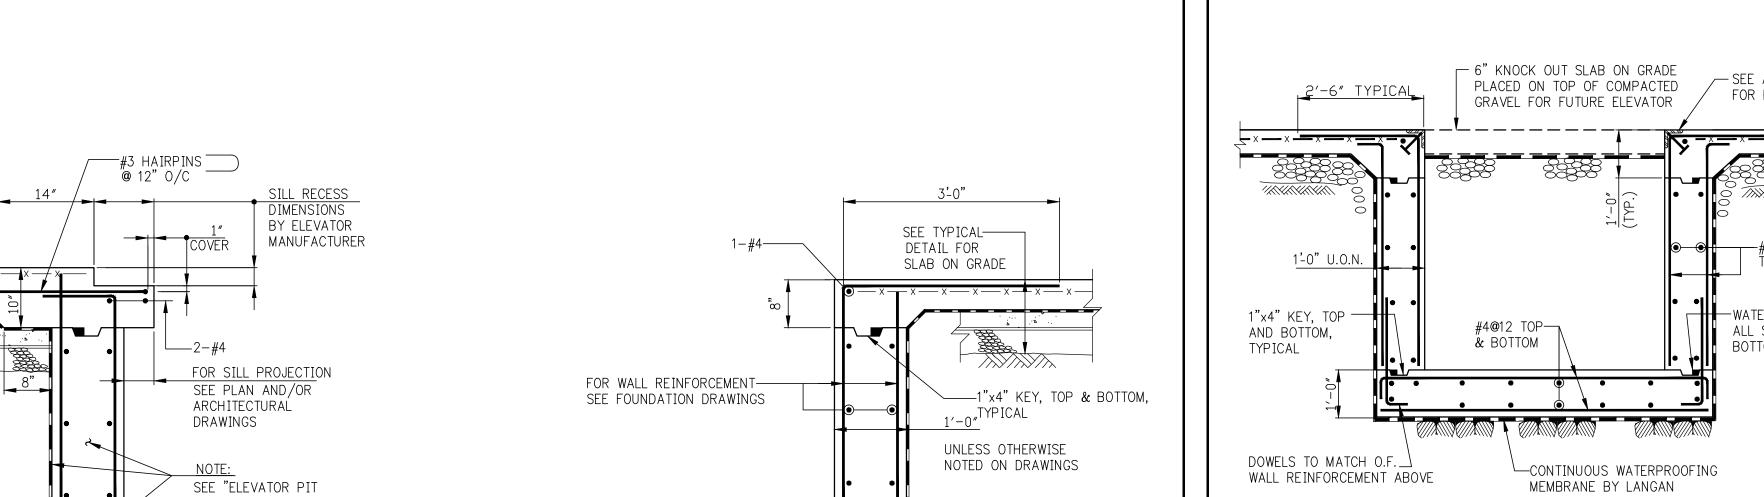



AT TOP OF WALL

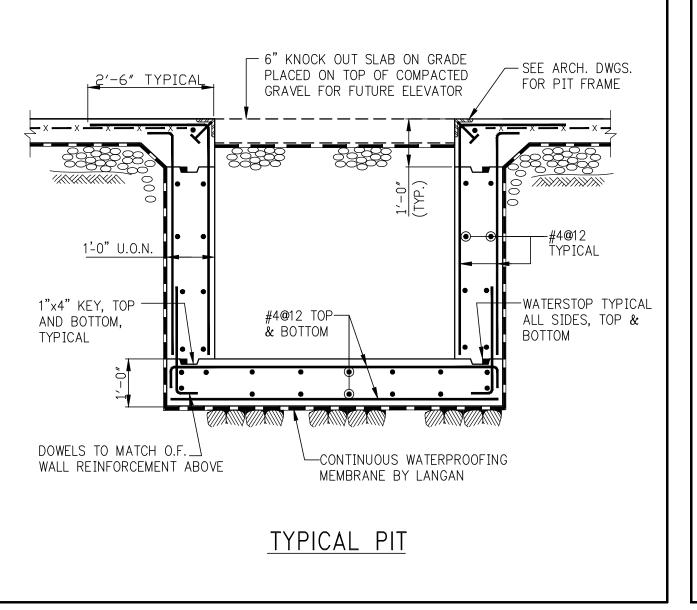

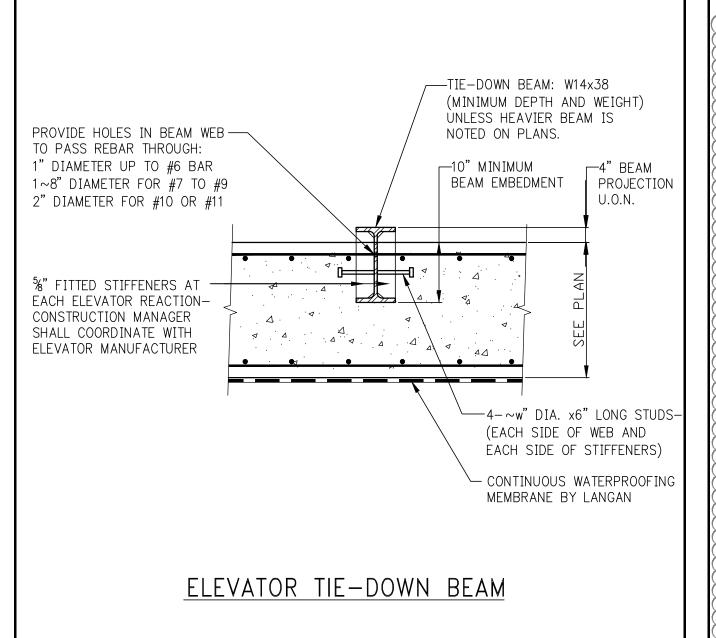

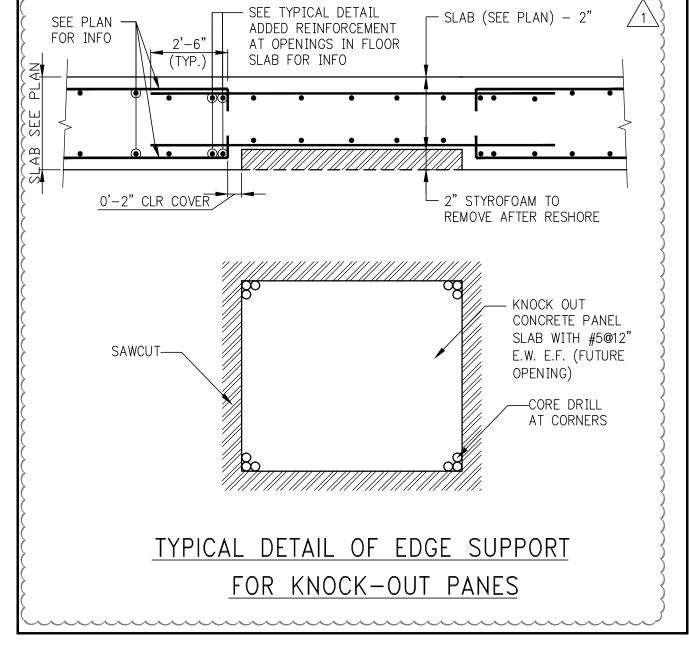

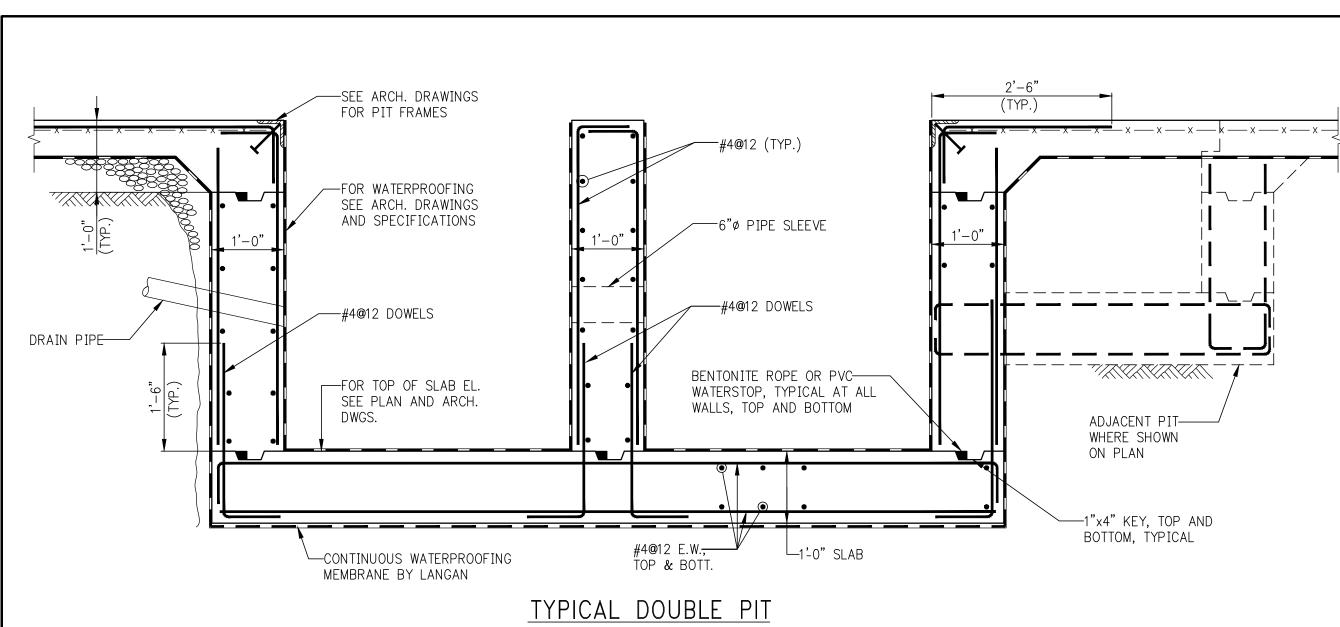

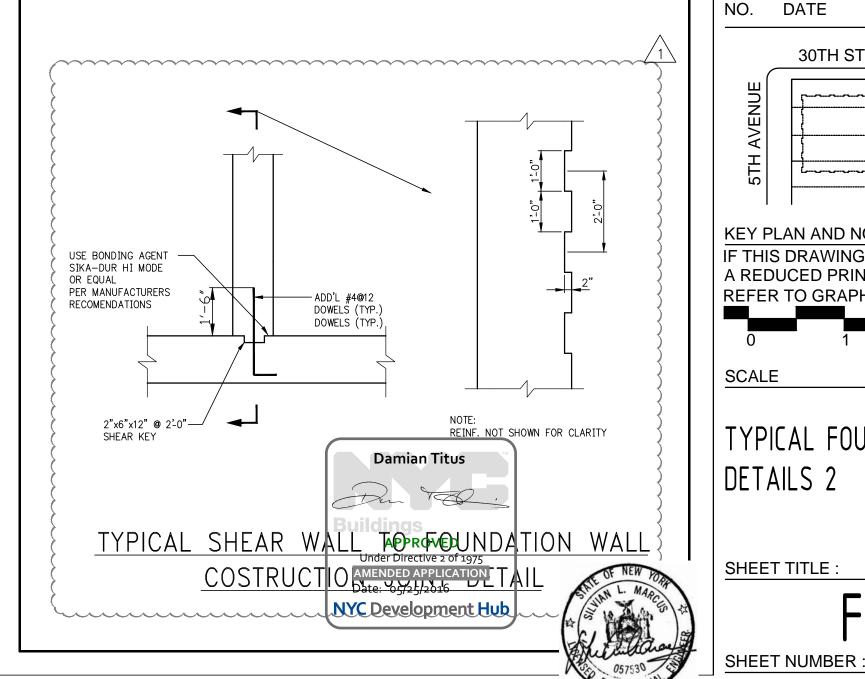

NEW YORK, NY

OWNER: VICTOR NOMAD LLC

TEL: 212 687 9888

CONSTRUCTION MANAGER: LEND LEASE 200 PARK AVENUE, 9TH FLOOR NEW YORK, NY 10166 TEL: 212 592 6700

ARCHITECT: RAFAEL VIÑOLY ARCHITECTS PC **50 VANDAM STREET** NEW YORK, NY 10013 TEL: 212 924 5060 FAX: 212 924 5858

STRUCTURAL ENGINEER: WSP GROUP 228 EAST 45TH STREET, 3RD FLOOR NEW YORK, NY 10017

MEP/FP/IT ENGINEER: MGE ENGINEERING 116 WEST 32ND STREET, 12TH FLOOR NEW YORK, NY 10001 TEL: 212 643 9055

GEOTECH CIVIL ENGINEER: LANGAN ENGINEERING 300 KIMBALL DRIVE, 4TH FLOOR PARSIPPANY, NJ, 07054 TEL: 973 560 4900

VERTICAL TRANSPORT. CONSULTANT: VAN DEUSEN & ASSOCIATES 120 EAGLE ROCK AVENUE, SUITE 310 EAST HANOVER, NJ, 07936

TEL: 973 994 9220 **ENCLOSURE CONSULTANT:** VIDARIS, INC. 360 PARK AVENUE SOUTH, 15TH FLOOR

TEL: 212 689 5389 **FACADE MAINTENANCE CONSULTANT:** ENTEK ENGINEERING LLC 166 AMES STREET HACKENSACK, NJ, 07601

ACOUSTICAL CONSULTANT: CERAMI & ASSOCIATES **404 FIFTH AVENUE** NEW YORK, NY, 10018 TEL: 212 616 4179

TEL: 201 820 2801

NEW YORK, NY, 10010

LIGHTING CONSULTANT: ONE LUX STUDIO 158 WEST 29TH STREET, 10TH FLOOR NEW YORK, NY, 10001 TEL: 212 201 5790

SPECIFICATIONS CONSULTANT: ROBERT SCHWARTZ & ASSOCIATES 589 EIGHTH AVENUE, 17TH FLOOR NEW YORK, NY, 10018 TEL: 212 691 3248

ENERGY MODELING CONSULTANT: STEVEN WINTER ASSOCIATES, INC 307 SEVENTH AVENUE, SUITE 1701 NEW YORK, NY, 10001

INTERIOR DESIGN CONSULTANT: JEFFREY BEERS INTERNATIONAL 156 5TH AVENUE, PENTHOUSE 2 NEW YORK, NY, 10010 TEL: 212 352 2020

DESIGN DEVELOPMENT NYC DEPT. OF BUILDINGS SUBMITTAL

ARCHITECT'S SEAL

TEL: 212 564 5800


04/29/2016 DOB FOUNDATION PAA #1 04/<u>08/2016</u> DOB SUBMITTAL 04/08/2016 SUPERSTRUCTURE EARLY BID

03/25/2016 DOB FOUNDATION POST APPROVAL AMENDMENT

01/27/2016 FOUNDATION BID ADD. #1 01/18/2016 FOUNDATION BID

12/23/2015 SCHEMATIC DESIGN 04/15/2015 DOB SUBMITTAL

04/01/2015 FOUNDATION BID 02/28/2015 SCHEMATIC DESIGN ISSUE ISSUE DESCRIPTION

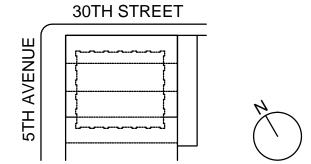



KEY PLAN AND NORTH SIGN IF THIS DRAWING IS NOT 42" X 30" IT IS A REDUCED PRINT; REFER TO GRAPHIC SCALE

N.T.S

TYPICAL FOUNDATION DETAILS 2

SHEET TITLE :

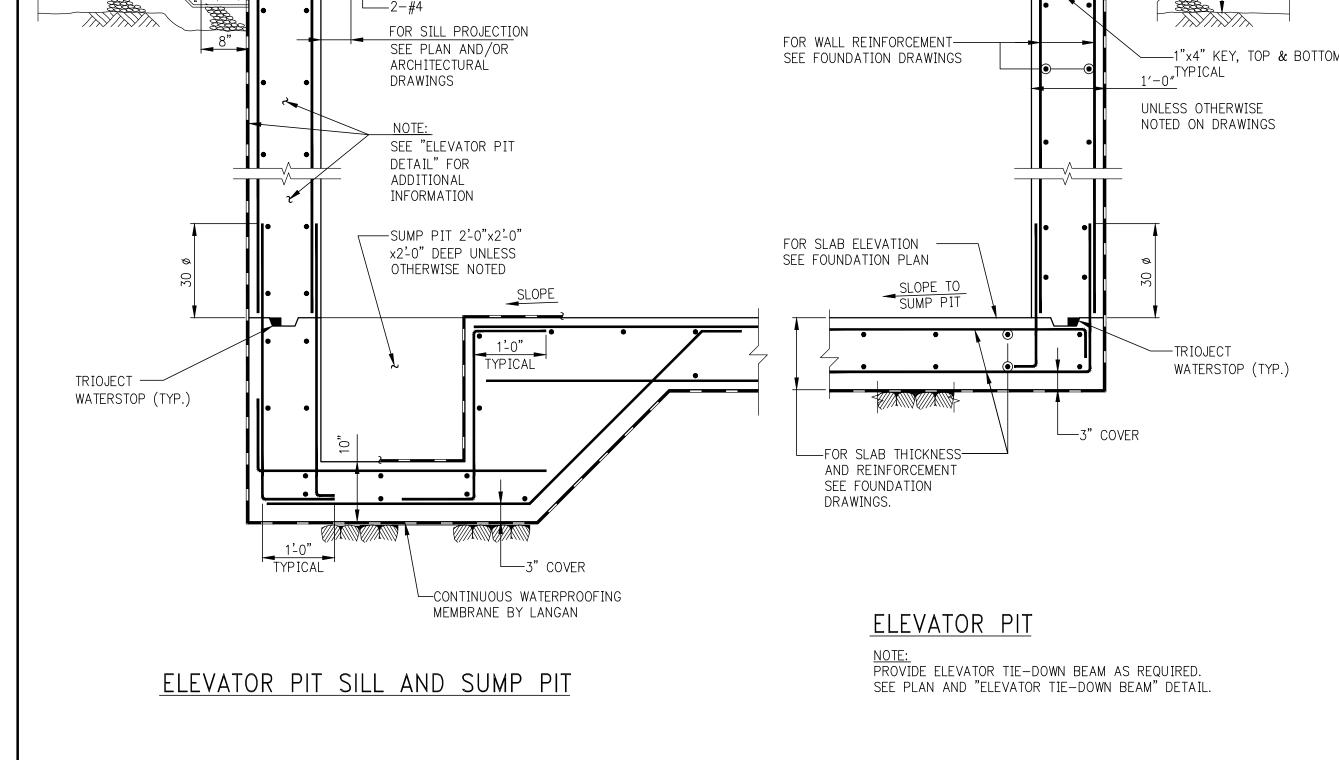

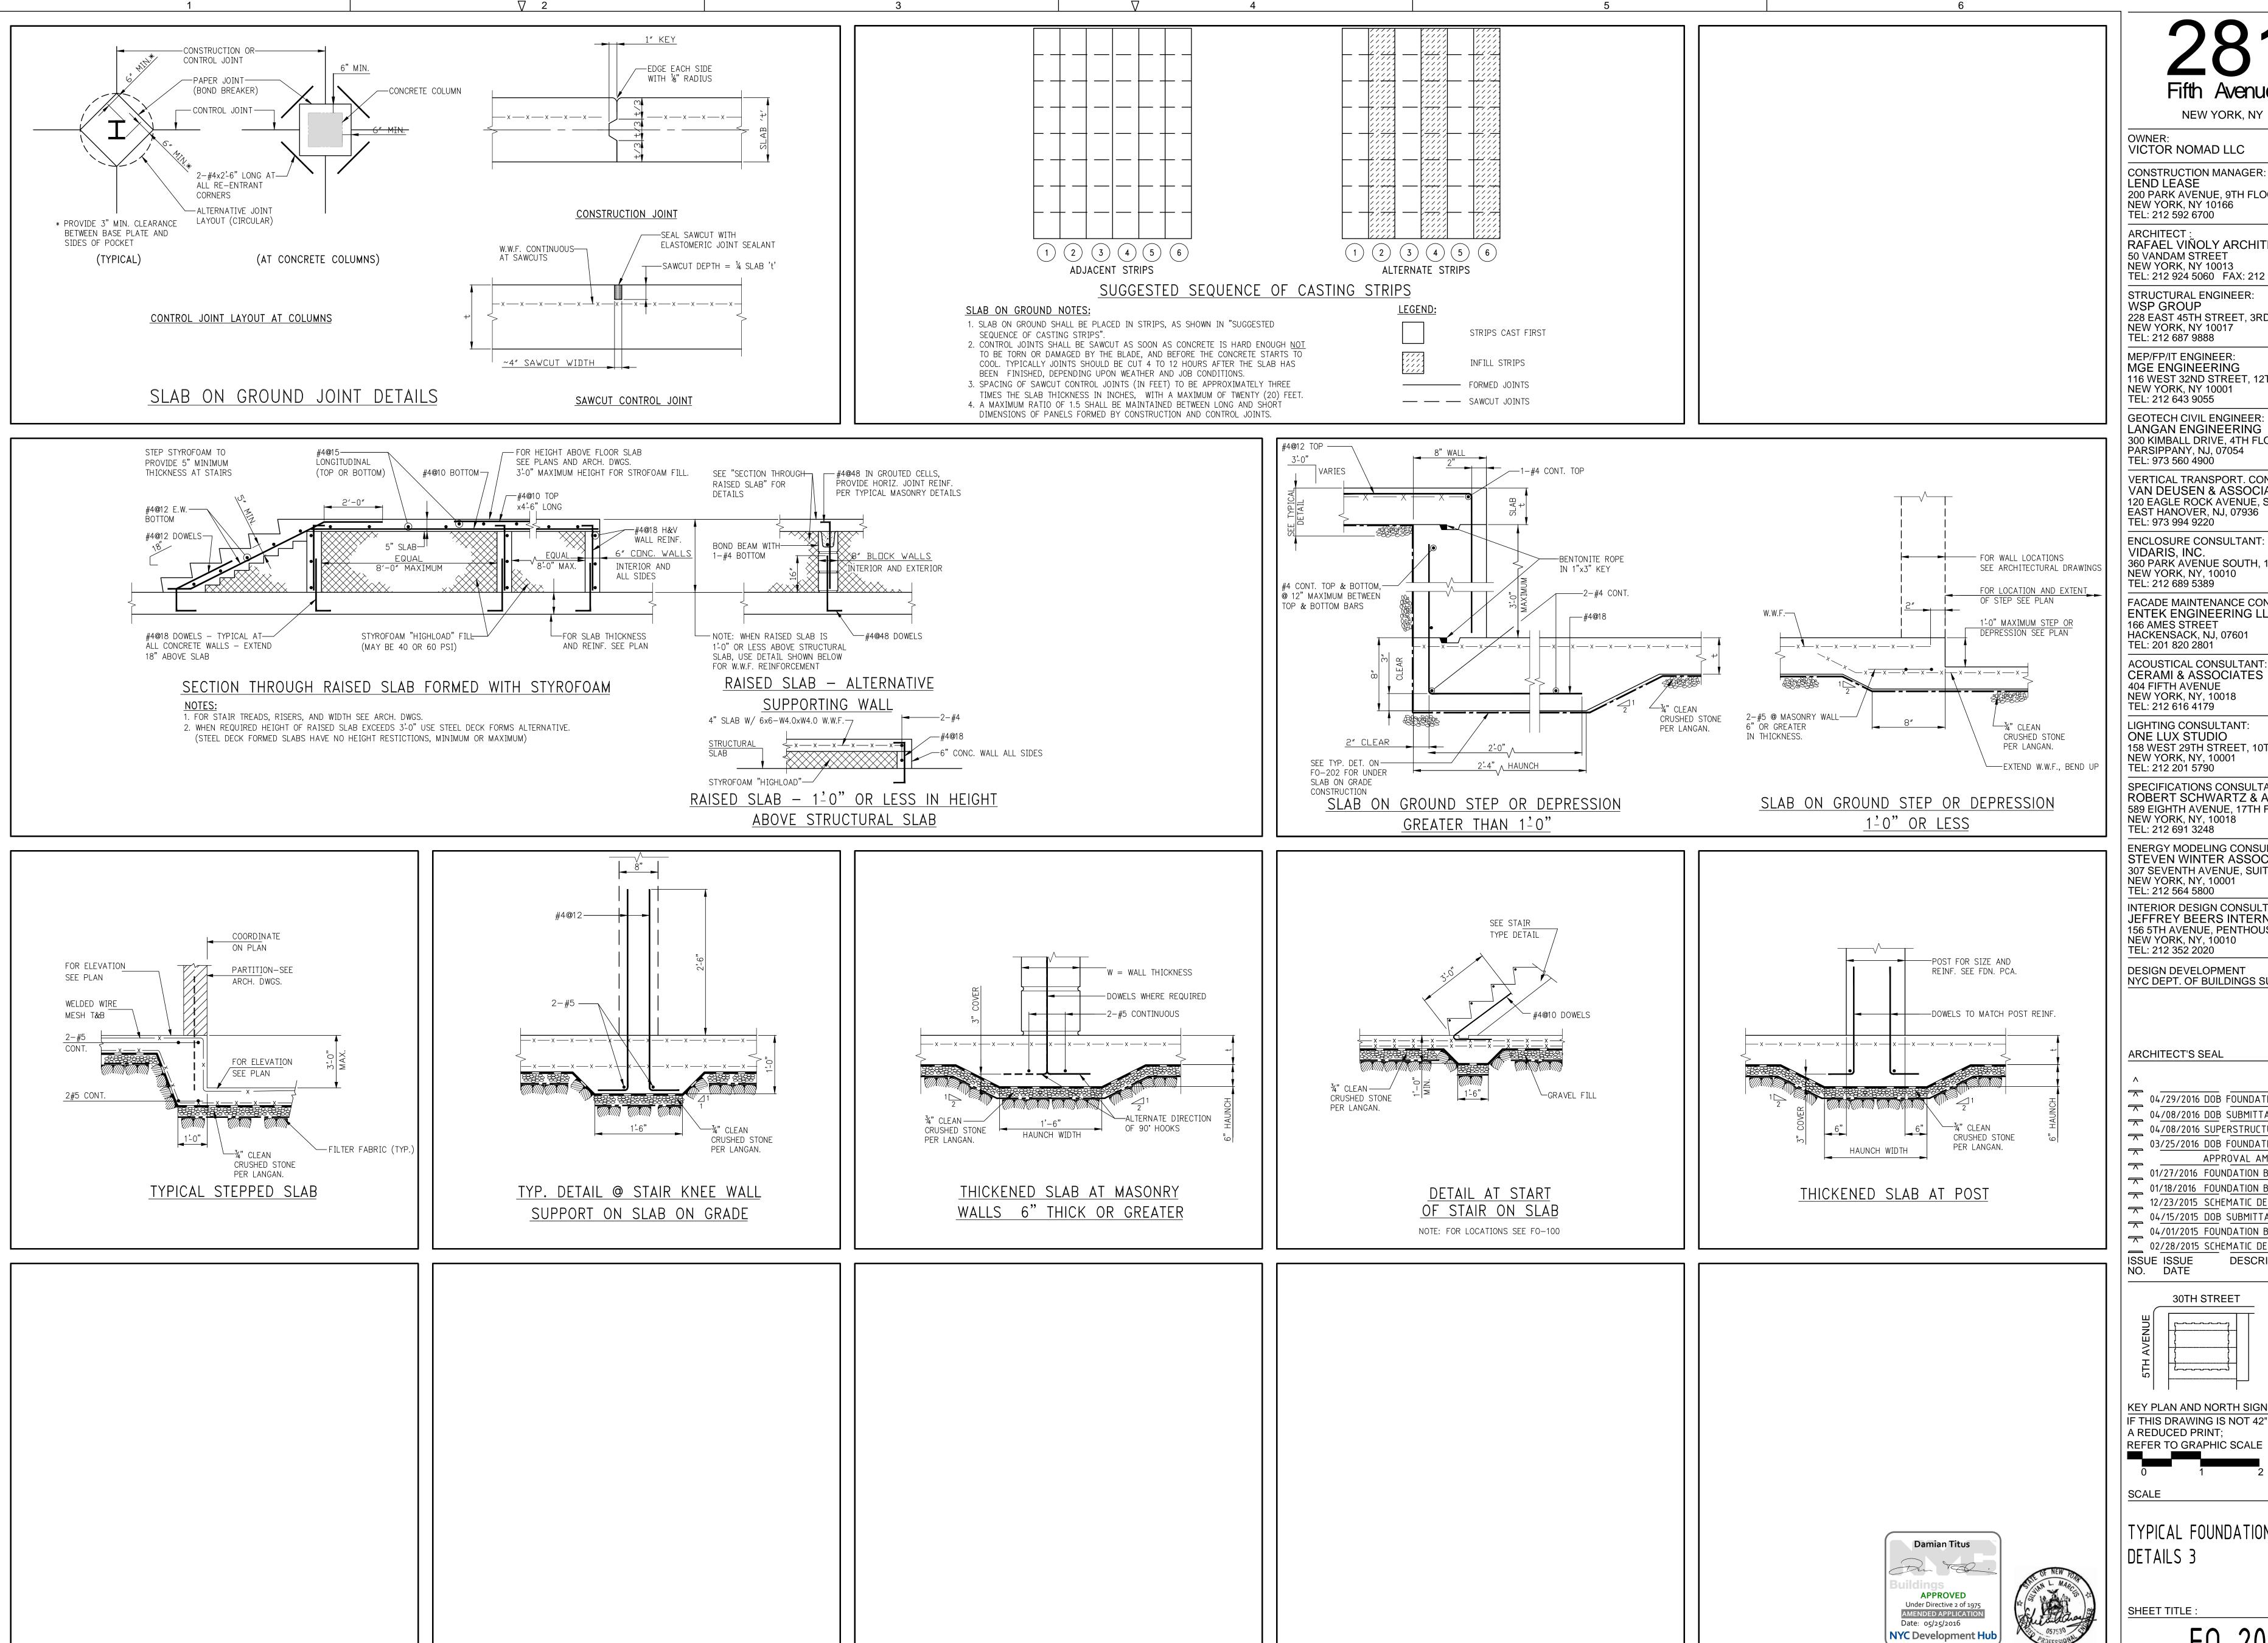

NEW YORK, NY

CONSTRUCTION MANAGER: LEND LEASE 200 PARK AVENUE, 9TH FLOOR

ARCHITECT : RAFAEL VIÑOLY ARCHITECTS PC 50 VANDAM STREET NEW YORK, NY 10013

TEL: 212 924 5060 FAX: 212 924 5858 STRUCTURAL ENGINEER: WSP GROUP 228 EAST 45TH STREET, 3RD FLOOR

MEP/FP/IT ENGINEER: MGE ENGINEERING 116 WEST 32ND STREET, 12TH FLOOR NEW YORK, NY 10001

TEL: 212 643 9055 **GEOTECH CIVIL ENGINEER:** LANGAN ENGINEERING 300 KIMBALL DRIVE, 4TH FLOOR

PARSIPPANY, NJ, 07054 TEL: 973 560 4900 **VERTICAL TRANSPORT. CONSULTANT:**

VAN DEUSEN & ASSOCIATES 120 EAGLE ROCK AVENUE, SUITE 310 EAST HANOVER, NJ, 07936 TEL: 973 994 9220

ENCLOSURE CONSULTANT: VIDARIS, INC. 360 PARK AVENUE SOUTH, 15TH FLOOR NEW YORK, NY, 10010 TEL: 212 689 5389

FACADE MAINTENANCE CONSULTANT: ENTEK ENGINEERING LLC 166 AMES STREET HACKENSACK, NJ, 07601 TEL: 201 820 2801

CERAMI & ASSOCIATES 404 FIFTH AVENUE NEW YORK, NY, 10018 TEL: 212 616 4179

LIGHTING CONSULTANT: ONE LUX STUDIO 158 WEST 29TH STREET, 10TH FLOOR **NEW YORK, NY, 10001** TEL: 212 201 5790

SPECIFICATIONS CONSULTANT: ROBERT SCHWARTZ & ASSOCIATES 589 EIGHTH AVENUE, 17TH FLOOR NEW YORK, NY, 10018 TEL: 212 691 3248

ENERGY MODELING CONSULTANT: STEVEN WINTER ASSOCIATES, INC 307 SEVENTH AVENUE, SUITE 1701 NEW YORK, NY, 10001

INTERIOR DESIGN CONSULTANT: JEFFREY BEERS INTERNATIONAL 156 5TH AVENUE, PENTHOUSE 2 NEW YORK, NY, 10010 TEL: 212 352 2020

DESIGN DEVELOPMENT NYC DEPT. OF BUILDINGS SUBMITTAL

ARCHITECT'S SEAL

04/29/2016 DOB FOUNDATION PAA #1 04/08/2016 DOB SUBMITTAL

04/08/2016 SUPERSTRUCTURE EARLY BID

03/25/2016 DOB FOUNDATION POST APPROVAL AMENDMENT

01/27/2016 FOUNDATION BID ADD. #1


01/18/2016 FOUNDATION BID 12/23/2015 SCHEMATIC DESIGN

04/15/2015 DOB SUBMITTAL

04/01/2015 FOUNDATION BID

02/28/2015 SCHEMATIC DESIGN ISSUE ISSUE NO. DATE DESCRIPTION

30TH STREET

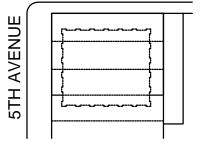

KEY PLAN AND NORTH SIGN IF THIS DRAWING IS NOT 42" X 30" IT IS A REDUCED PRINT;

REFER TO GRAPHIC SCALE

TYPICAL FOUNDATION

TABLE #1: TENSION LAP SPLICE LENGTHS (CLASS B MINIMUM) || TABLE 1.A: 34" COVER TO OUTER LAYER BARS || TABLE 1.C: 11/2" COVER TO OUTER LAYER BARS OUTER LAYER LAP LENGTHS (IN INCHES) OUTER LAYER LAP LENGTHS (IN INCHES) NOTE: USE TABLE 1.A IF BAR SPACING IS LESS | THAN 4" O/C UP TO #8, 5" O/C FOR #9, #10, #11 $\frac{1}{4}$ $\frac{1}$ #10 | 121 | 105 | 94 | 86 | 79 | 74 | 70 | 66 **||** #10 | 79 | 68 | 61 | 56 | 51 | 49 | 49 | 49 | #11 | 140 | 122 | 109 | 99 | 92 | 86 | 81 | 77 || #11 | 92 | 80 | 72 | 65 | 60 | 57 | 54 | 54 $\|\mathsf{TABLE}\ \mathsf{1.B:}\ \ ^3\!\!4$ $^{\prime\prime}$ COVER to outer layer bars $\|\mathsf{TABLE}\ \mathsf{1.D:}\ \mathsf{1}\ \ ^1\!\!2$ $^{\prime\prime}$ COVER to outer layer bars INNER LAYER LAP LENGTHS (IN INCHES) INNER LAYER LAP LENGTHS (IN INCHES) NOTE: USE TABLE 1.A IF BAR SPACING IS LESS NOTE: USE TABLE 1.A IF BAR SPACING IS LESS THAN 4" O/C UP TO #8, 5" O/C FOR #9, #10, #11 | THAN 5" O/C UP TO #8, 6" O/C FOR #9, #10, # f'c 3,000 4,000 5,000 6,000 7,000 8,000 9,000 10,000 BAR 3,000 4,000 5,000 6,000 7,000 8,000 9,000 10,000 $\frac{1}{2}$ | 3.000 | 4.000 | 5.000 | 6,000 | 7,000 | 8,000 | 9,000 | 10,000 | 10 #9 | 75 | 65 | 58 | 53 | 49 | 46 | 44 | 44 || #9 | 53 | 46 | 44 | 44 | 44 | 44 | 44 | 44

NOTES FOR TENSION LAP SPLICES


- 1. REINFORCEMENT IS UNCOATED, WITH Fy=60,000 PSI. 2. CONCRETE IS NORMAL WEIGHT (144-150#/C.F.).
- 3. FOR "TOP" BAR SPLICE LENGTHS ("TOP" IS DEFINED BY ACI 318 AS HAVING MORE THAN 12 INCHES OF FRESH CONCRETE CAST BELOW THE BAR), TABULATED LENGTHS MUST BE MULTIPLIED BY 1.3.
- 4. LENGTHS TABULATED MUST BE MULTIPLIED BY THE FOLLOWING MODIFICATION FACTORS: a. LIGHTWEIGHT CONCRETE1.3 b. EPOXY-COATED BARS:

2.) ALL OTHER CONDITIONS1.2

- 1.) BARS WITH COVER < 3db, <u>OR</u> WITH CLEAR SPACING < 6db ...1.5 FOR BOTTOM & VERTICAL BARS, 1.3 FOR 'TOP' BARS *
- FOR COMBINED FACTORS = 1.75. WHERE TENSION DEVELOPMENT LENGTH (Ld)

* FOR EPOXY-COATED 'TOP' BARS THE MAXIMUM

- IS REQUIRED ON PLANS OR IN DETAILS, SEE TENSION DEVELOPMENT LENGTH TABLES. 6. CLASS A LAP SPLICE LENGTHS ARE EQUAL TO TENSION
- DEVELOPMENT LENGTHS. SEE TABLES FOR TENSION DEVELOPMENT LENGTHS (Ld). APPLY APPROPRIATE MODIFICATION FACTORS TO CLASS A SPLICE LENGTHS. $/_1$ 7. ALL #11 BARS TO BE 75ksi. TABULATED LENGTH MUST BE MÜLTIPLIED BY 1.25.

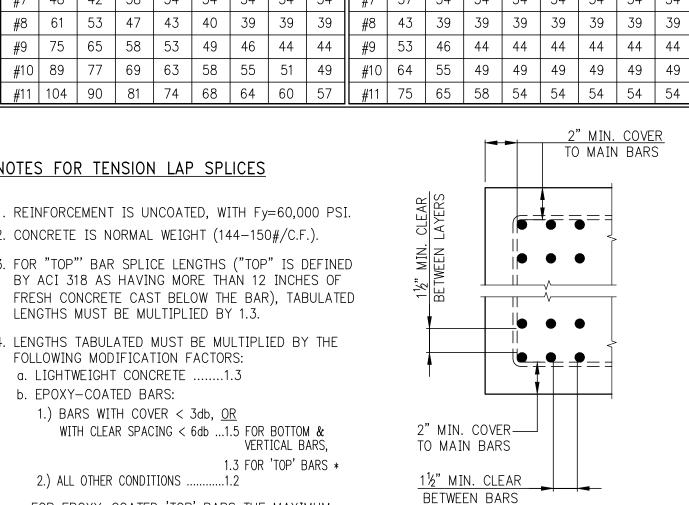

MULTIPLE LAYERS PROVIDE MINIMUM COVER AND CLEARANCES SHOWN, USE TABLE 1.A FOR LAP SPLICE LENGTHS.

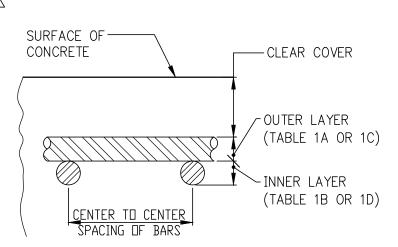


TABLE #2: TENSION DEVELOPMENT LENGTHS (Ld) (IN INCHES) TABLE 2.A: 34" COVER TO OUTER LAYER BARS TABLE 2.C: 11/2" COVER TO OUTER LAYER BARS OUTER LAYER DEVELOPMENT LENGTHS) OUTER LAYER DEVELOPMENT LENGTHS ∑° | 3.000 | 4.000 | 5.000 | 6.000 | 7.000 | 8.000 | 9.000 | 10.000 | 10.000 | 4.000 | 5,000 | 6,000 | 7,000 | 8,000 | 9,000 | 10,000 | #6 | 33 | 28 | 25 | 23 | 22 | 20 | 19 | 18 || #6 | 20 | 17 | 15 | 15 | 15 | 15 | 15 | 15 | #7 | 53 | 46 | 41 | 37 | 35 | 32 | 31 | 29 || #7 | 32 | 28 | 25 | 23 | 21 | 20 | 19 | 18 #8 | 66 | 57 | 51 | 46 | 43 | 40 | 38 | 36 | #8 | 41 | 36 | 32 | 29 | 27 | 25 | 24 | 23 | #9 | 79 | 69 | 61 | 56 | 52 | 49 | 46 | 43 || #9 | 50 | 44 | 39 | 36 | 33 | 31 | 29 | 28 #10 | 93 | 81 | 72 | 66 | 61 | 57 | 54 | 51 | | #10 | 60 | 52 | 47 | 43 | 40 | 37 | 35 | 33 #11 | 108 | 94 | 84 | 76 | 71 | 66 | 62 | 59 | | #11 | 71 | 61 | 55 | 50 | 46 | 43 | 41 | 39 TABLE 2.B: 34" COVER TO OUTER LAYER BARS TABLE 2.D: 11/2" COVER TO OUTER LAYER BARS INNER LAYER DEVELOPMENT LENGTHS INNER LAYER DEVELOPMENT LENGTHS [...£c | 3.000 | 4.000 | 5.000 | 6.000 | 7.000 | 8.000 | 9.000 | 10.000 | ...£c | 3.000 | 4.000 | 5.000 | 6.000 | 7.000 | 8.000 | 9.000 | 10.000 | #5 | 16 | 14 | 13 | 13 | 13 | 13 | 13 | 13 | #5 | 16 | 14 | 13 | 13 | 13 | 13 | 13 | 13 | #6 | 23 | 20 | 18 | 16 | 15 | 15 | 15 | 15 || #6 | 20 | 17 | 15 | 15 | 15 | 15 | 15 | 15 #7 | 37 | 32 | 29 | 26 | 24 | 23 | 22 | 20 **||** #7 | 29 | 25 | 22 | 20 | 19 | 18 | 18 | 18 #8 | 47 | 41 | 36 | 33 | 31 | 29 | 27 | 26 | #8 | 33 | 28 | 25 | 23 | 22 | 20 | 20 | 20 | #9 | 57 | 50 | 44 | 41 | 38 | 35 | 33 | 31 || #9 | 41 | 35 | 31 | 29 | 27 | 25 | 23 | 23

#10 | 68 | 59 | 53 | 48 | 45 | 42 | 40 | 38 || #10 | 49 | 42 | 38 | 35 | 32 | 30 | 28 | 27

#11 | 80 | 69 | 62 | 57 | 52 | 49 | 46 | 44 | | #11 | 58 | 50 | 45 | 41 | 38 | 35 | 33 | 32

NOTES FOR TENSION DEVELOPMENT <u>LENGTHS (Ld)</u>

- 1. REINFORCEMENT IS UNCOATED, WITH Fy=60,000 PSI.
- 2. CONCRETE IS NORMAL WEIGHT (144-150#/C.F.). 3. FOR "TOP" BAR DEVELOPMENT LENGTHS ("TOP" IS DEFINED BY ACI 318 AS HAVING MORE THAN 12 INCHES OF


FRESH CONCRETE CAST BELOW THE BAR), TABULATED

- LENGTHS MUST BE MULTIPLIED BY 1.3. 4. LENGTHS TABULATED MUST BE MULTIPLIED BY THE FOLLOWING MODIFICATION FACTORS:
- a. LIGHTWEIGHT CONCRETE1.3 b. EPOXY-COATED BARS:
- 1.) BARS WITH COVER < 3db, <u>OR</u> WITH CLEAR SPACING < 6db ...1.5 FOR BOTTOM &
- VERTICAL BARS,
- * FOR EPOXY-COATED 'TOP' BARS THE MAXIMUM FOR COMBINED FACTORS = 1.7
- 5. WHERE TENSION DEVELOPMENT LENGTH (Ld) IS REQUIRED ON PLANS OR IN DETAILS, SEE TENSION DEVELOPMENT LENGTH TABLES.
- 6. CLASS A LAP SPLICE LENGTHS ARE EQUAL TO TENSION DEVELOPMENT LENGTHS. SEE TABLES FOR TENSION DEVELOPMENT LENGTHS (Ld). APPLY APPROPRIATE MODIFICATION FACTORS TO CLASS A SPLICE LENGTHS.

TABLE #3 TENSION DEVELOPMENT LENGTHS FOR STANDARD END HOOKS (Idh) (LENGTHS IN INCHES)

BAR	CONCRETE STRENGTH (PSI)							
SIZE	3,000	4,000	5,000	6,000	7,000	8,000	9,000	10,000
#3	9	7	7	6	6	6	6	6
#4	11	10	9	8	7	7	7	6
#5	14	12	11	10	9	9	8	8
#6	17	15	13	12	11	10	10	9
#7	19	17	15	14	13	12	11	11
#8	22	19	17	16	15	14	13	12
#9	25	22	19	18	16	15	15	14
#10	28	24	22	20	19	17	16	16
#11	31	27	24	22	21	19	18	17
#14	37	32	29	27	25	23	22	21
#18	50	43	39	35	33	31	29	27
NOTE	ς.	_	_	_	_			

- 1. TABLE 3 CONFORMS TO ACI 318-2002 (AND 2005). TABULATED VALUES ARE BASED UPON ACI 12.5.2, ASSUMING GRADE 60
- REINFORCEMENT AND NORMALWEIGHT CONCRETE. 2. PER ACI 12.5.3 a), FOR #11 AND SMALLER BARS, IF COVER TO BAR IS 2½ INCHES OR MORE, AND FOR 90 DEGREE HOOK WITH COVER ON BAR EXTENSION BEYOND HOOK NOT LESS THAN 2 INCHES, A MODIFICATION FACTOR OF 0.7 MAY BE APPLIED. MINIMUM Idh SHALL

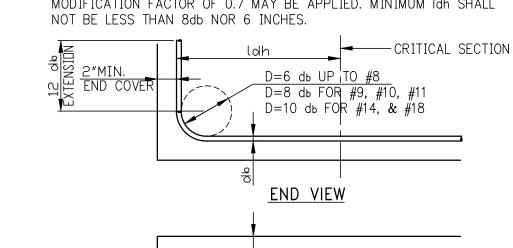

2½" MIN.—

SIDE COVER

TABLE #4 COMPRESSION LAP SPLICES (LENGTHS IN INCHES)

(==::::::::::::::::::::::::::::::::::::						
BAR	GRADE OF REINFORCEMENT					
SIZE	60 KSI (30 DIA.)	75 KSI (44 DIA.)	80 KSI (48 DIA.)			
#3	12	17	18			
#4	15	22	24			
# 5	19	28	30			
#6	23	33	36			
#7	27	39	42			
#8	30	44	48			
#9	34	50	54			
#10	38	56	61			
#11	43	62	68			
#14 AND #18	 LAP SPLICES ARE NOT PERMITTED USE MECHANICAL CONNECTIONS OR WELDED SPLICES FOR #14 AND #18, PER ACI 318 (12.14.3). LAP SPLICES OF #14 AND #18 BARS TO #11 AND SMALLER BARS ARE PERMITTED PER 					

ACI 318 (12.16.2). 3. FOR BARS OF DIFFERENT SIZE, USE LARGER OF: SPLICE LENGTH OF SMALLER BAR (TABLE #4) OR DEVELOPMENT LENGTH OF LARGER BAR (FROM TABLE #5) PER ACI 318 (12.16.2).

TABLE #4 APPLIES FOR NORMALWEIGHT CONCRETE WITH f'c = 3,000 PSI OR

TABLE #5 DEVELOPMENT LENGTHS FOR BARS IN COMPRESSION

(LENGTHS IN INCHES)

	fy = 60,000 PSI			fy = 75,000 PSI			fy = 80,000 PSI		
BAR	CONC. f'c (IN PSI)			CONC. f'c (IN PSI)			CONC. f'c (IN PSI)		
SIZE	3,000	4,000	5,000 OR MORE	3,000	4,000	5,000 OR MORE	3,000	4,000	5,000 OR MORE
#3	12	12	12	12	12	12	12	12	12
#4	12	12	12	14	12	12	15	13	12
#5	14	12	12	17	15	14	18	16	15
#6	17	15	14	21	18	17	22	19	18
#7	19	17	16	24	21	20	26	22	21
#8	22	19	18	28	24	23	29	25	24
#9	25	22	21	31	27	25	33	28	27
#10	28	24	23	34	30	28	36	31	30
#11	31	27	26	38	33	31	40	34	33
#14	37	32	31	48	42	39	51	44	42
#18	50	43	41	62	54	51	65	56	54

NEW YORK, NY

OWNER: VICTOR NOMAD LLC

CONSTRUCTION MANAGER: LEND LEASE 200 PARK AVENUE, 9TH FLOOR NEW YORK, NY 10166 TEL: 212 592 6700

ARCHITECT RAFAEL VIÑOLY ARCHITECTS PC 50 VANDAM STREET NEW YORK, NY 10013

TEL: 212 924 5060 FAX: 212 924 5858 STRUCTURAL ENGINEER: WSP GROUP 228 EAST 45TH STREET, 3RD FLOOR

TEL: 212 687 9888 MEP/FP/IT ENGINEER: MGE ENGINEERING 116 WEST 32ND STREET, 12TH FLOOR NEW YORK, NY 10001

NEW YORK, NY 10017

TEL: 212 643 9055 GEOTECH CIVIL ENGINEER: LANGAN ENGINEERING 300 KIMBALL DRIVE, 4TH FLOOR PARSIPPANY, NJ, 07054

TEL: 973 560 4900 VERTICAL TRANSPORT. CONSULTANT: VAN DEUSEN & ASSOCIATES 120 EAGLE ROCK AVENUE, SUITE 310 EAST HANOVER, NJ, 07936 TEL: 973 994 9220

ENCLOSURE CONSULTANT: VIDARIS, INC. 360 PARK AVENUE SOUTH, 15TH FLOOR NEW YORK, NY, 10010

FACADE MAINTENANCE CONSULTANT: ENTEK ENGINEERING LLC 166 AMES STREET HACKENSACK, NJ, 07601 TEL: 201 820 2801

ACOUSTICAL CONSULTANT: CERAMI & ASSOCIATES 404 FIFTH AVENUE NEW YORK, NY, 10018 TEL: 212 616 4179

TEL: 212 689 5389

LIGHTING CONSULTANT: ONE LUX STUDIO 158 WEST 29TH STREET, 10TH FLOOR NEW YORK, NY, 10001 TEL: 212 201 5790

SPECIFICATIONS CONSULTANT: ROBERT SCHWARTZ & ASSOCIATES 589 EIGHTH AVENUE, 17TH FLOOR NEW YORK, NY, 10018 TEL: 212 691 3248

ENERGY MODELING CONSULTANT: STEVEN WINTER ASSOCIATES, INC. 307 SEVENTH AVENUE, SUITE 1701 NEW YORK, NY, 10001

INTERIOR DESIGN CONSULTANT: JEFFREY BEERS INTERNATIONAL 156 5TH AVENUE, PENTHOUSE 2 NEW YORK, NY, 10010 TEL: 212 352 2020

DESIGN DEVELOPMENT NYC DEPT. OF BUILDINGS SUBMITTAL

ARCHITECT'S SEAL

TEL: 212 564 5800

04/29/2016 DOB FOUNDATION PAA #1


04/08/2016 DOB SUBMITTAL _ 04/08/2016 SUPERSTRUCTURE EARLY BID 03/25/2016 DOB FOUNDATION POST


APPROVAL AMENDMENT 01/27/2016 FOUNDATION BID ADD. #1

01/18/2016 FOUNDATION BID 12/23/2015 SCHEMATIC DESIGN 04/15/2015 DOB SUBMITTAL $\overline{}$

04/01/2015 FOUNDATION BID 02/28/2015 SCHEMATIC DESIGN ISSUE ISSUE DESCRIPTION

NO. DATE

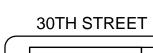

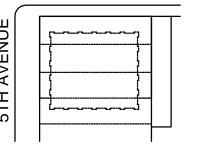


KEY PLAN AND NORTH SIGN IF THIS DRAWING IS NOT 42" X 30" IT IS A REDUCED PRINT; REFER TO GRAPHIC SCALE


TYPICAL FOUNDATION DETAILS 4

APPROVED
Under Directive 2 of 1975
AMENDED APPLICATION

 Date: 05/25/2016 NYC Development Hub SHEET TITLE :





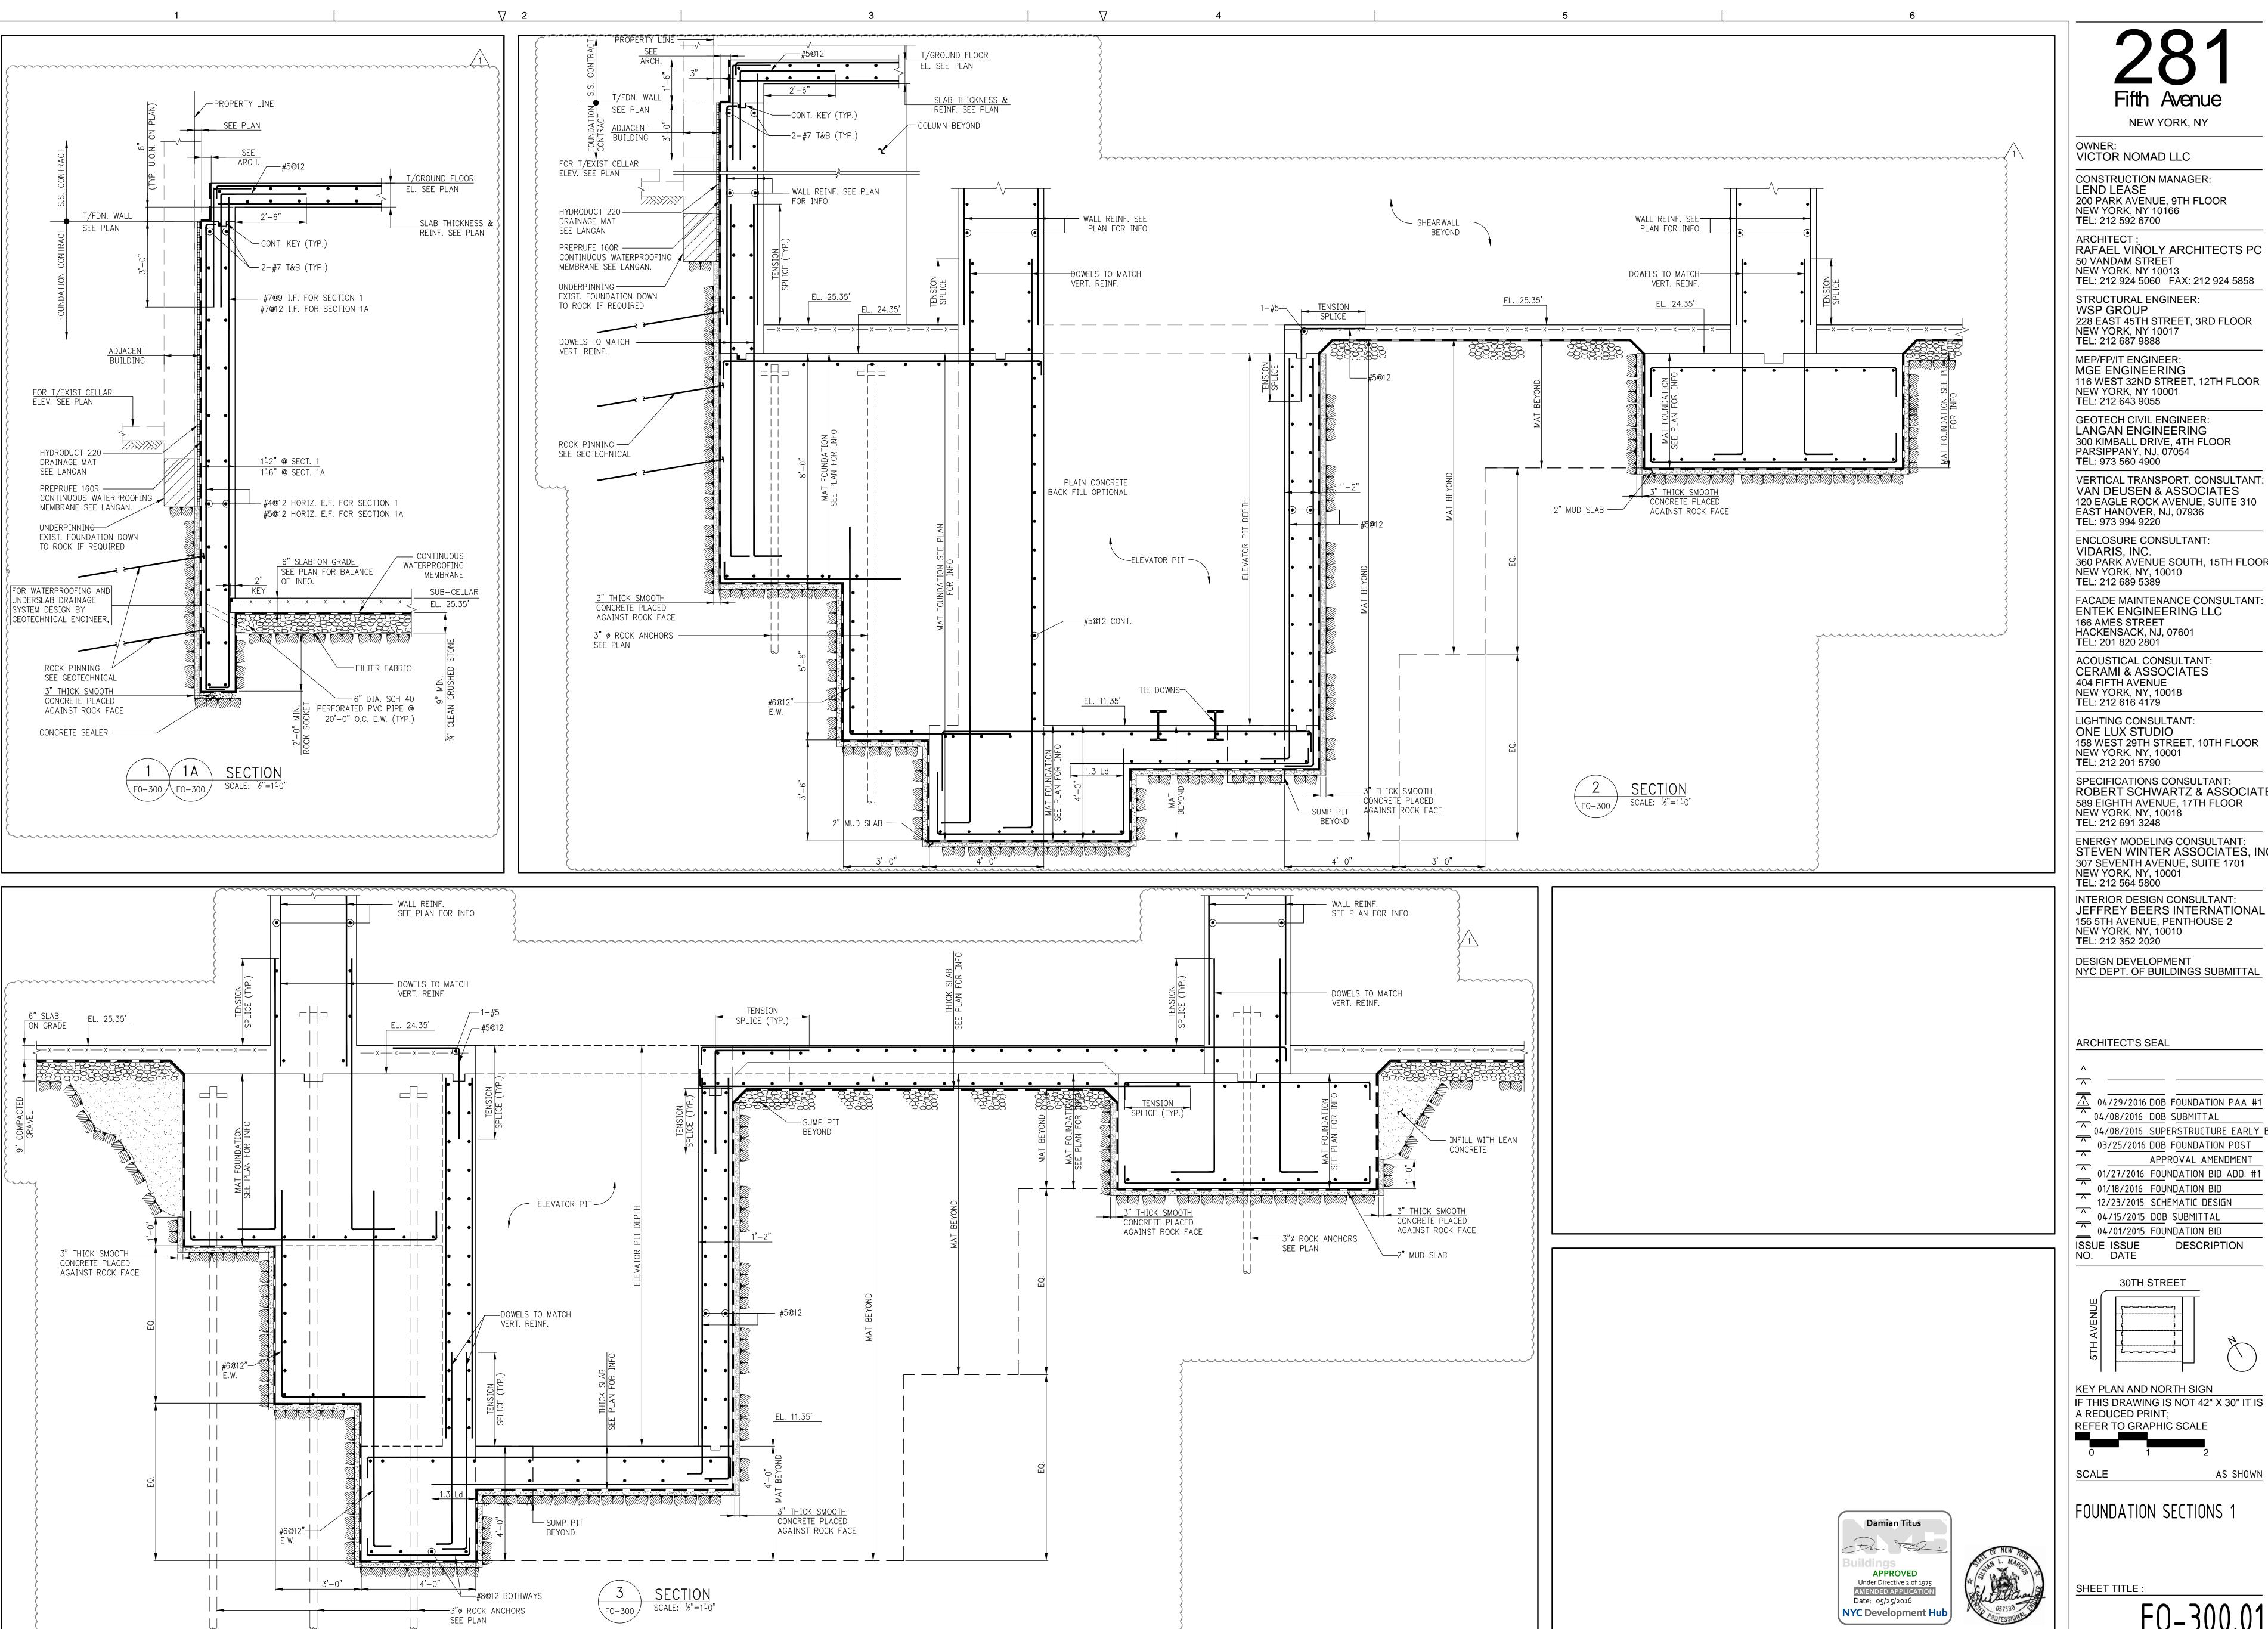

RAFAEL VIÑOLY ARCHITECTS PC

TEL: 212 924 5060 FAX: 212 924 5858

228 EAST 45TH STREET, 3RD FLOOR

116 WEST 32ND STREET, 12TH FLOOR

VAN DEUSEN & ASSOCIATES 120 EAGLE ROCK AVENUE, SUITE 310

360 PARK AVENUE SOUTH, 15TH FLOOR

158 WEST 29TH STREET, 10TH FLOOR

ROBERT SCHWARTZ & ASSOCIATES 589 EIGHTH AVENUE, 17TH FLOOR

ENERGY MODELING CONSULTANT: STEVEN WINTER ASSOCIATES, INC

INTERIOR DESIGN CONSULTANT: JEFFREY BEERS INTERNATIONAL

_ 04/08/2016 SUPERSTRUCTURE EARLY BID

03/25/2016 DOB FOUNDATION POST APPROVAL AMENDMENT

IF THIS DRAWING IS NOT 42" X 30" IT IS

ROBERT SCHWARTZ & ASSOCIATES

STEVEN WINTER ASSOCIATES, INC